

Paul H. Helland, 1107 Technology Parkway, Cedar Falls, Iowa 50613-6951, (319)-266-0161

UNITED STATES PUBLIC LAND SURVEY CORNER CERTIFICATE
OF

LAND SURVEY MONUMENTS SITUATED IN SECTION NO. 15, TOWNSHIP NO. 89 NORTH, RANGE NO. 12 WEST OF THE FIFTH PRINCIPAL MERIDIAN, BLACK HAWK COUNTY, IOWA.
PREVIOUSLY RECORDED IN N/A

(SHOW REASON FOR PREPARING THIS CERTIFICATE, THE EVIDENCE AND DETAILED PROCEDURES USED IN ESTABLISHING THE CORNER POSITIONS AND MONUMENTATION FOUND OR PLACED.)


MONUMENT DESCRIPTION AND REMARKS:

NO USPLSCC ON FILE. SURVEY COMPLETED IN THE SE 1/4 OF SEC. 15-T89N-R12W & IN THE NW 1/4 OF SEC. 14-T89N-R12W.

- NE CORNER NW 1/4 SE 1/4: NO BLACK HAWK COUNTY ENGINEER TIES AVAILABLE. PER SURVEOR'S RECORDS BY JOHN BALL DATED 1800'S CALLS FOR [STONE]. SEARCHED IN APPROXIMATE AREA WHERE THE EXTENSION OF OLD FENCE LINES FROM THE EAST AND SOUTH WOULD MEET. FOUND LIMESTONE 0.1' DEEP (0.6'L x 0.15'W x 0.9'H). SET NO. 4 REBAR w/OPC #6505 0.15' EAST OF SAID LIMESTONE FOR MAGNETIC DETECTION. UTILIZED HIGH POINT ON SAID LIMESTONE AS CORNER.


PLAN VIEW

(SHOW A MINIMUM OF THREE REFERENCE TIES TO DURABLE PHYSICAL OBJECTS, RELEVANT MONUMENTS AND PHYSICAL CONDITIONS THAT WILL ENABLE RECOVERY OF THE CORNER.)

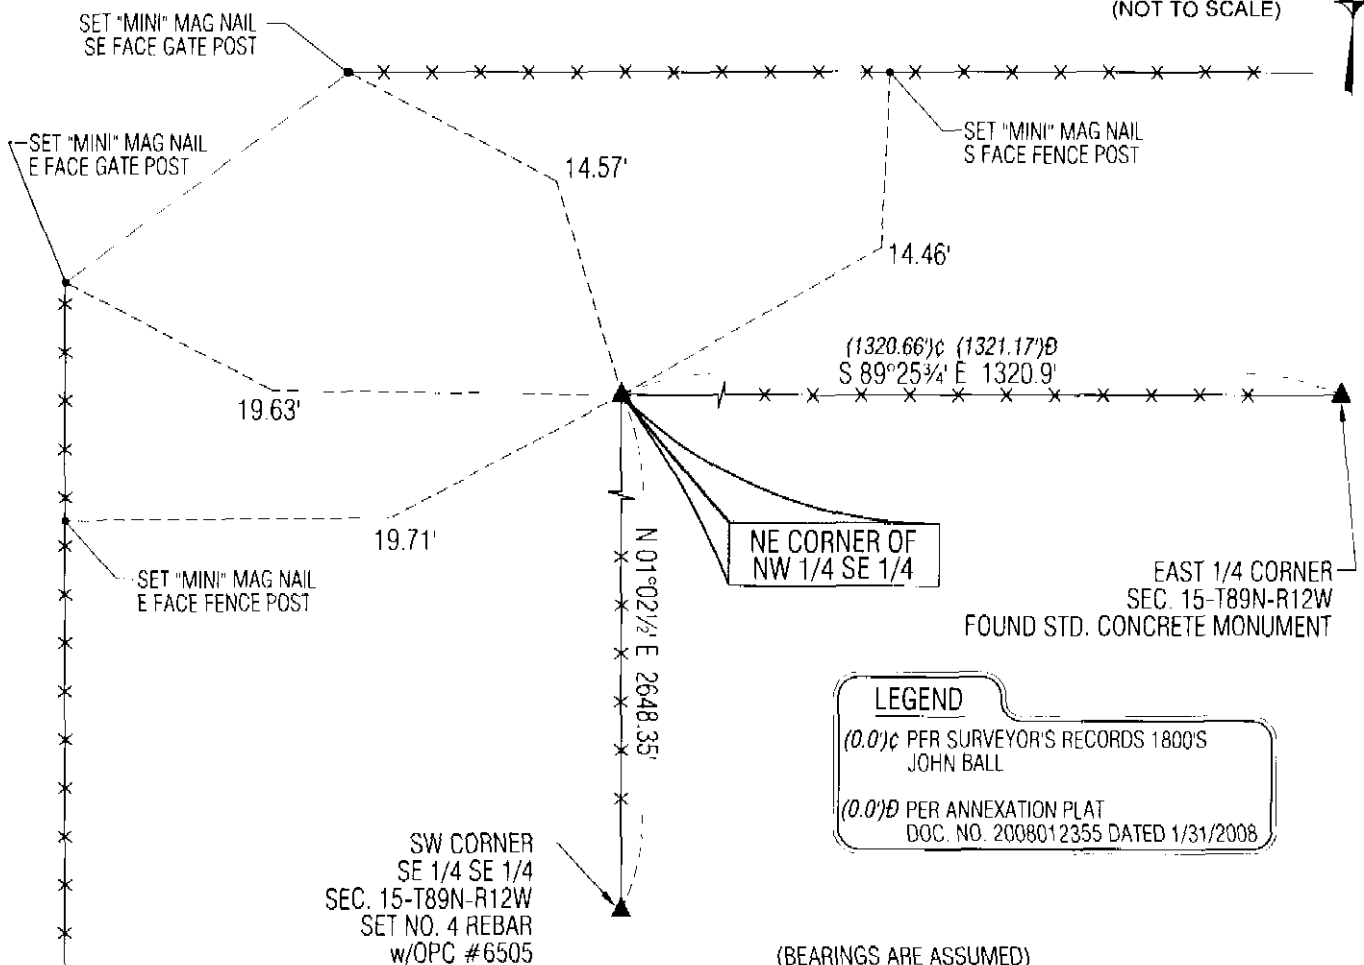

HELLAND ENGINEERING & SURVEYING, LTD.
1107 Technology Parkway
Cedar Falls, Iowa 50613-6951
(319)-266-0161

SHINER = 8D NAIL & 1 5/16"Ø METAL SHINER
BRASS TAG = 8D NAIL & 13/16"Ø BRASS TAG
OPC = PLASTIC CAP (O=ORANGE, R=RED, Y=YELLOW)
(00') RECORDED AS FILE NAME: 12-172C3.DWG

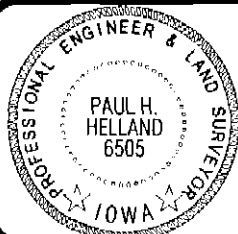

I hereby certify that this land surveying document was prepared and the related survey work was performed by me or under my direct personal supervision and that I am a duly licensed Land Surveyor under the laws of the State of Iowa.

Paul H. Helland
License Number 6505
My license renewal date is December 31, 2013.
All pages or sheets are covered by this seal except:

LIST CORNERS TO BE INDEXED			
CORNER	SECTION	TOWNSHIP	RANGE
NE COR. NW 1/4 SE 1/4	15	89N	12W
SE COR. SW 1/4 NE 1/4	15	89N	12W
SW COR. SE 1/4 NE 1/4	15	89N	12W
NW COR. NE 1/4 SE 1/4	15	89N	12W

File Number: 2013-00001965 Seq: 1