

SLSI 9-90

UNITED STATES PUBLIC LAND SURVEY CORNER CERTIFICATE

OF

Land Survey Monuments situated in Section 16, Township 89 N, Range 12 W, of the Fifth Principal Meridian, _____ County, Iowa.
Previously recorded in _____ in County Recorder's Office.


(book, page, document number, etc.)

(Show reason for preparing this certificate, the evidence and detailed procedures used in establishing the corner positions and monumentation found or placed.)

Monument Description and Remarks: CONCRETE MONUMENT WITH ALUMINUM CAP
SET IN EAST SHOULDER OF ELK RUN ROAD.

PLAN - VIEW

(Show a minimum of three reference ties to durable physical objects, relevant monuments and physical conditions that will enable recovery of the corner.)

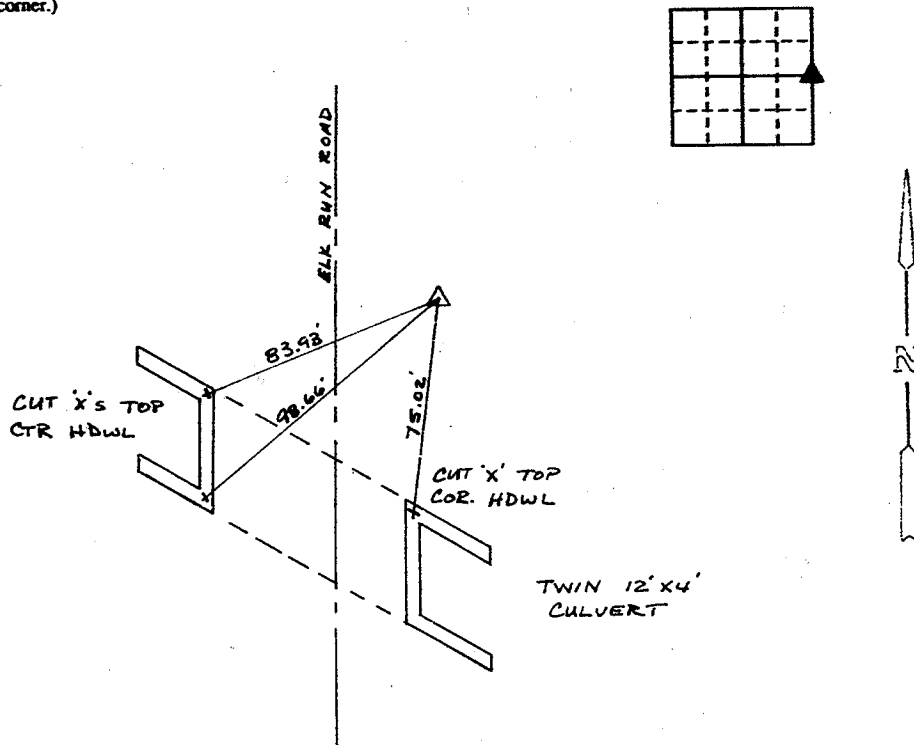

I hereby certify that the survey work was completed and this certificate was prepared by me or under my direct personal supervision and that I am a duly registered land surveyor under the laws of the state of Iowa.

Signature: Michael R Fagle
Name typed or printed: MICHAEL R. FAGLE

Date: 5-4-92 Reg. No. 8505



SEAL

Corners	List Corners to be Indexed	Section	Twp	Range
E. 1/4 COR	16	89 N	12 W	

10 30145 60