

IAS
P
Z

Document Number: 2008009408
Date: Oct 31, 2007 4:30:00 pm
Aud Fee: 0.00 Rec Fee: 0.00
Trans Tax: 0.00 Rec Management Fee: 0.00
E-Com Fee: 0.00 Non-Standard Page Fee: 0.00
Filed for record in Black Hawk County, Iowa
Judith A. McCarthy, County Recorder

PREPARED BY: BLACK HAWK COUNTY ENGINEERS OFFICE
316 E. FIFTH STREET, ROOM 211 WATERLOO, IOWA 50703
PH.# (319) 833-3008 SLSI 9-94
FAX.# (319) 833-3139 CERT 12-96

UNITED STATES PUBLIC LAND SURVEY CORNER CERTIFICATE OF
Land Survey Monuments situated in Section 16, Township 89 N,
Range 12 W, of the Fifth Principal Meridian, BLACK HAWK County, Iowa.
Previously recorded in Misc. Book n/a, Page n/a, in County Recorder's Office.

(Show reason for preparing this certificate, the evidence and detailed procedures used in establishing the corner positions and monumentation found or placed.)


Monument Description and Remarks: 5/8" REBAR w/ 2" ALUM. CAP STAMPED
"BLACK HAWK COUNTY LAND CORNER", PER TEMP. TIES IN BOOK 479 p.31 OF
COUNTY ENG. SURVEY RECORD. COR. REF. FROM RESURF. PROJECT IN 2001,
AS RE-SET FROM FND. LEAD PLUG. CORNER LOC. ±C.L. ACC, AND BEING TIED
TO UPDATE PUBLIC RECORD AT REQUEST FOR PLAT OF SURVEY NORTH.

PLAN - VIEW

(Show a minimum of three reference ties to durable physical objects, relevant monuments and physical conditions that will enable recovery of the corner.)


NOTES:

- 1.) TIE DIST. PER REFLECTORLESS EDM MEAS. IN "MISSING LINE MEAS." MODE, BEING HORIZ. (H.D.).
- 2.) "S.M." DENOTES "SURVEY MARKER"

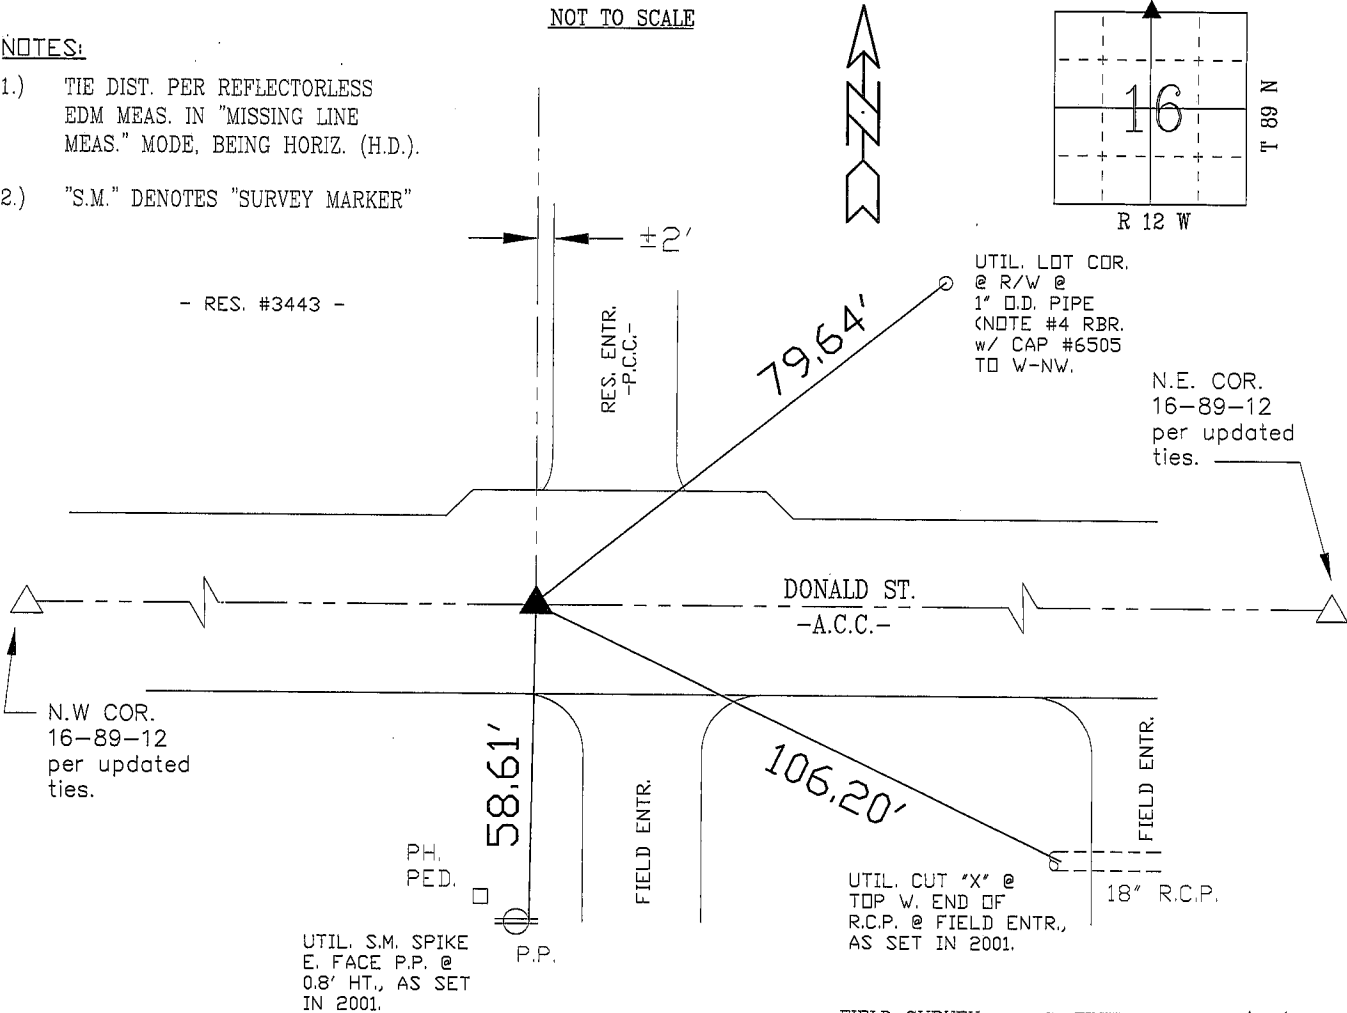

FIELD SURVEY: G. TINKER 10/30/07
PREPARED BY: G. TINKER 10/30/07

CERTIFICATION

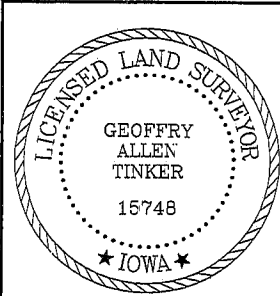

I hereby certify that this land surveying document was prepared and the related survey work was performed by me or under my direct personal supervision and that I am a duly licensed Land Surveyor under the laws of the State of Iowa.
Geoffry Allen Tinker 10/30/07 (date)
License Number 15748
My license renewal date is December 31, 2008
Pages or sheets covered by this seal:
This Land Corner Certificate Only.

LIST CORNERS TO BE INDEXED

Corner	Section	Township	Range
N. 1/4	16	89 N	12 W
S. 1/4	9	89 N	12 W