

MISC  
SC  
INDEX *Sr*  
MARGIN  
PROOF *gr*  
COMPARE *rc*

BLACK HAWK COUNTY IOWA, SS:  
Filed for record AUG 16, 2001 at  
11:00 A.M. and recorded in Book 343  
of MISC at Page 582

*Christina S. Sess* Recorder  
FEE N/C  
BLACK HAWK COUNTY ENGINEER

PREPARED BY: BLACK HAWK COUNTY ENGINEERS OFFICE PH.# (319) 833-3008 SLSI 9-94  
316 E. FIFTH STREET, ROOM 211 WATERLOO, IOWA 50703 FAX.# (319) 833-3139 CERT 12-96

UNITED STATES PUBLIC LAND SURVEY CORNER CERTIFICATE OF  
Land Survey Monuments situated in Section 17, Township 89 N,  
Range 12 W, of the Fifth Principal Meridian, BLACK HAWK County, Iowa.  
Previously recorded in Misc. Book N/A, Page N/A, in County Recorder's Office.

(Show reason for preparing this certificate, the evidence and detailed procedures used in establishing the corner positions and monumentation found or placed.)

Monument Description and Remarks: RE-EST. DUE TO ACC RESURFACING PROJECT. FOUND 3/4" PIN IN PCC PAVEMENT PRIOR TO RESURFACING. REF. AS DENOTED BELOW, AND RESET CORNER WITH 6" L. x 5/8" RBR. W/ 2" ALUM. CAP AFTER ACC RESURFACING.


PLAN - VIEW

(Show a minimum of three reference ties to durable physical objects, relevant monuments and physical conditions that will enable recovery of the corner.)

NOTE:

ALL DISTANCES PLUMB  
"S.M." DENOTES "SURVEY MARKER"

NOT TO SCALE

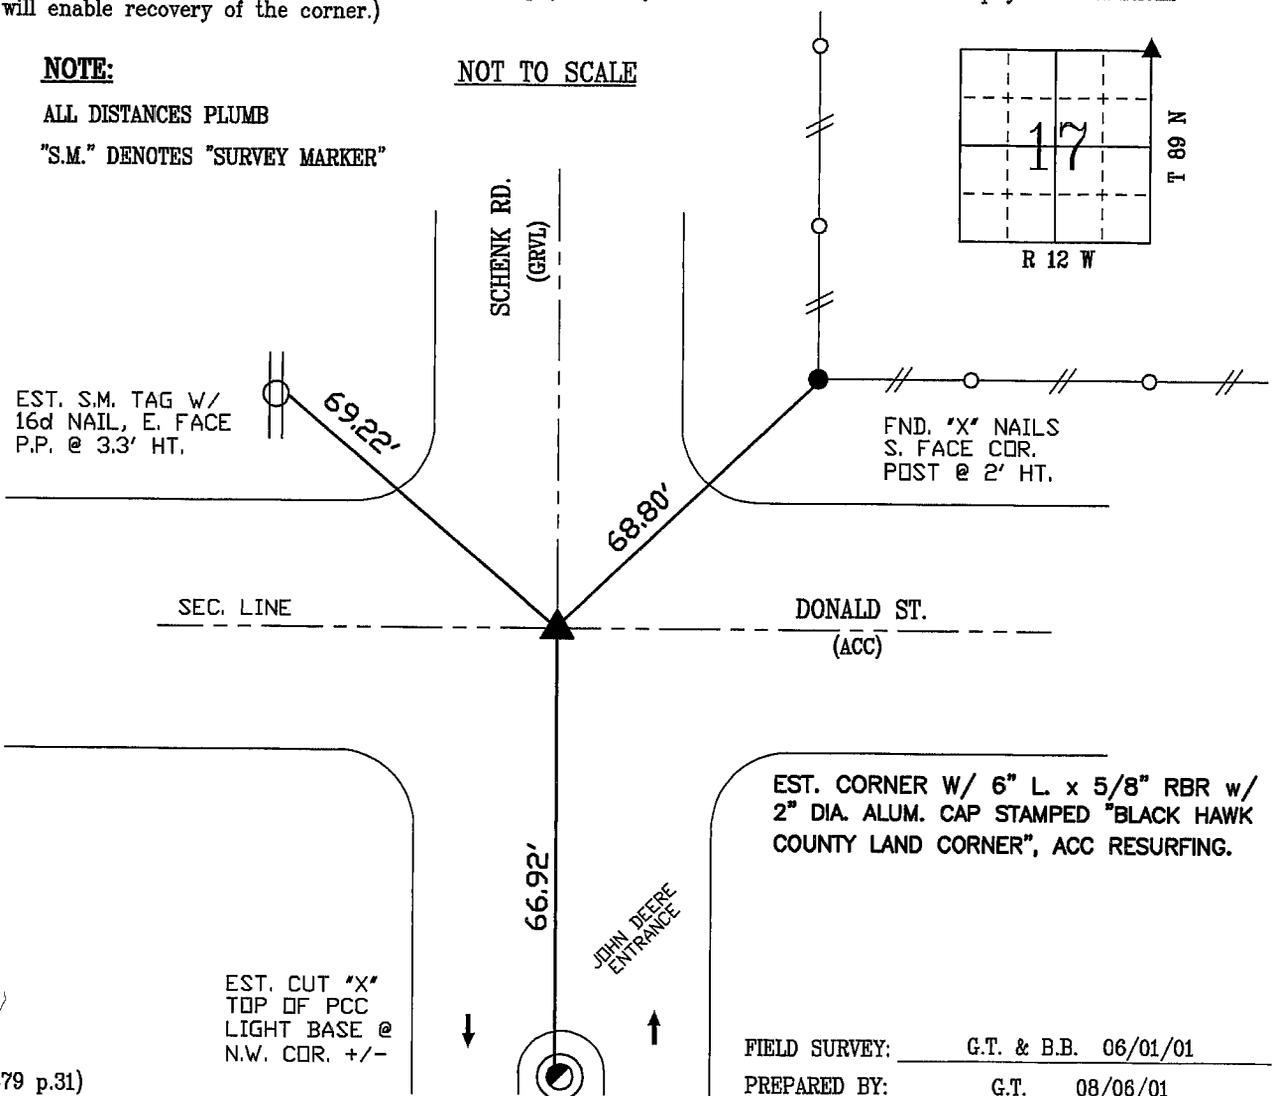

(FLD. BK 479 p.31)

CERTIFICATION

I hereby certify that this land surveying document was prepared and the related survey work was performed by me or under my direct personal supervision and that I am a duly licensed Land Surveyor under the laws of the State of Iowa.

*Richard L. King* 8/13/01  
Richard L. King (date)

License Number 3890

My license renewal date is December 31, 2001

Pages or sheets covered by this seal:

This Land Corner Certificate Only.

LIST CORNERS TO BE INDEXED

Corner	Section	Township	Range
N.E.	17	89 N	12 W
N.W.	16	89 N	12 W
S.E.	8	89 N	12 W
S.W.	9	89 N	12 W