

Reserved for County Recorder's use.

Doc ID: 008257830001 Type: GEN  
Recorded: 10/23/2017 at 10:02:49 AM  
Fee Amt: \$7.00 Page 1 of 1  
Black Hawk County Iowa  
SANDIE L. SMITH RECORDER  
File **2018-00007099**

Kyle J. Helland, 1107 Technology Parkway, Cedar Falls, Iowa 50613-6951, (319)-266-0161

# UNITED STATES PUBLIC LAND SURVEY CORNER CERTIFICATE OF

LAND SURVEY MONUMENTS SITUATED IN SECTION NO. 18, TOWNSHIP NO. 89 NORTH, RANGE NO. 12 WEST OF THE FIFTH PRINCIPAL MERIDIAN, BLACK HAWK COUNTY, IOWA.  
PREVIOUSLY RECORDED IN N/A

(SHOW REASON FOR PREPARING THIS CERTIFICATE, THE EVIDENCE AND DETAILED PROCEDURES USED IN ESTABLISHING THE CORNER POSITIONS AND MONUMENTATION FOUND OR PLACED.)


### MONUMENT DESCRIPTION AND REMARKS:

NO USPLSCC ON FILE. SURVEY COMPLETED IN THE SW 1/4 NE 1/4 OF SEC. 18-T89N-R12W.

→ **NE CORNER OF NW 1/4 SE 1/4:** NO COUNTY ENGINEER REFERENCE TIES AVAILABLE. PLAT OF SURVEY 249 MISC. 964 DATED 03/18/1983 CALLS FOR [SET IRON PIN w/REG. CAP #6505]. PLAT OF SURVEY 251 MISC. 327 DATED 06/24/1983 CALLS FOR [SET IRON PIN w/REG. CAP #6505]. SEARCHED AREA, FOUND NO. 4 REBAR w/OPC #6505 0.5'± NORTH OF DOWNED EAST-WEST FENCE LINE.

## PLAN VIEW

(SHOW A MINIMUM OF THREE REFERENCE TIES TO DURABLE PHYSICAL OBJECTS, RELEVANT MONUMENTS AND PHYSICAL CONDITIONS THAT WILL ENABLE RECOVERY OF THE CORNER.)

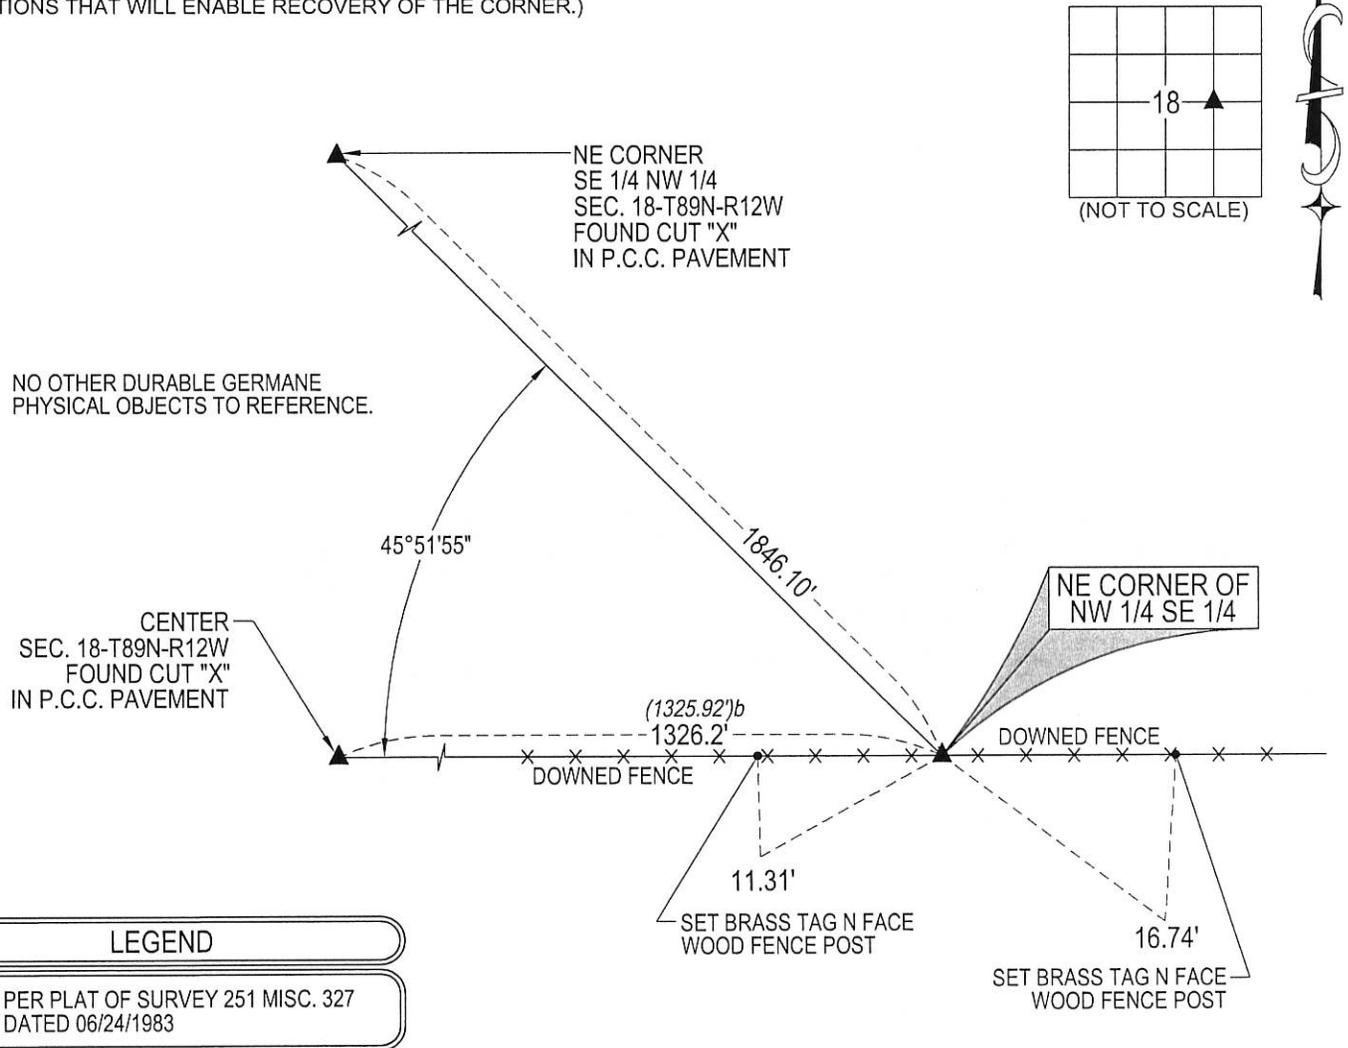

**LEGEND**

(0.0')<sup>b</sup> PER PLAT OF SURVEY 251 MISC. 327 DATED 06/24/1983

**HES** HELLAND ENGINEERING & SURVEYING, LTD.  
1107 Technology Parkway  
Cedar Falls, Iowa 50613-6951  
(319)-266-0161

SHINER = 8d. NAIL & 1 5/16"Ø METAL SHINER DRAWN BY: JBL  
BRASS TAG = 8d. NAIL & 13/16"Ø BRASS TAG  
OPC = PLASTIC CAP (O=ORANGE, R=RED, Y=YELLOW)  
(00') RECORDED AS FILE NAME: 17-207-33.DWG



I hereby certify that this land surveying document was prepared and the related survey work was performed by me or under my direct personal supervision and that I am a duly licensed Professional Land Surveyor under the laws of the State of Iowa.

*Kyle J. Helland*  
Kyle J. Helland  
License Number 23212  
My license renewal date is December 31, 2017.  
All pages or sheets are covered by this seal except:

| LIST CORNERS TO BE INDEXED |         |          |       |
|----------------------------|---------|----------|-------|
| CORNER                     | SECTION | TOWNSHIP | RANGE |
| NE COR. NW 1/4 SE 1/4      | 18      | 89N      | 12W   |
| SE COR. SW 1/4 NE 1/4      | 18      | 89N      | 12W   |
| SW COR. SE 1/4 NE 1/4      | 18      | 89N      | 12W   |
| NW COR. NE 1/4 SE 1/4      | 18      | 89N      | 12W   |