

INDEX
MARGIN
PROOF
COMPARE

FILED IN PUBLIC RECORDS IOWA. 33
Filed for record Aug 6, 1999, at
4:00 P.M. and recorded in Book 335
of MISC Page 427.
Patricia J. Lass Recorder
Fee 1-5.00/
WAYNE CLAASSEN ENGINEERING & SURVEYING

WAYNE CLAASSEN ENGINEERING AND SURVEYING, INC.
P.O. BOX 898 WATERLOO, IOWA 50704-0898

PHONE: (VOICE) 319-235-6294
(FAX) 319-235-0028

UNITED STATES PUBLIC LAND SURVEY CORNER CERTIFICATE


Survey Monuments situated in Section 20, Township 39N, Range 12W, of the Fifth Principal Meridian, Black Hawk County, Iowa.
Previously recorded in MISC. 299-397 in County Recorder's Office.
(book, page, document number, etc.)

Now reason for preparing this certificate, the evidence and detailed procedures used in establishing the corner positions monumentation found or placed.)

Monument Description and Remarks Pipe & cap noted in MISC 299-397 was missing.
Found SCM 25" deep, reset pipe & cap No. 8033 over monument & set survey
marker sign on steel post

PLAN - VIEW

Now a minimum of three reference ties to durable physical objects, relevant monuments and physical conditions that enable recovery of the corner.)

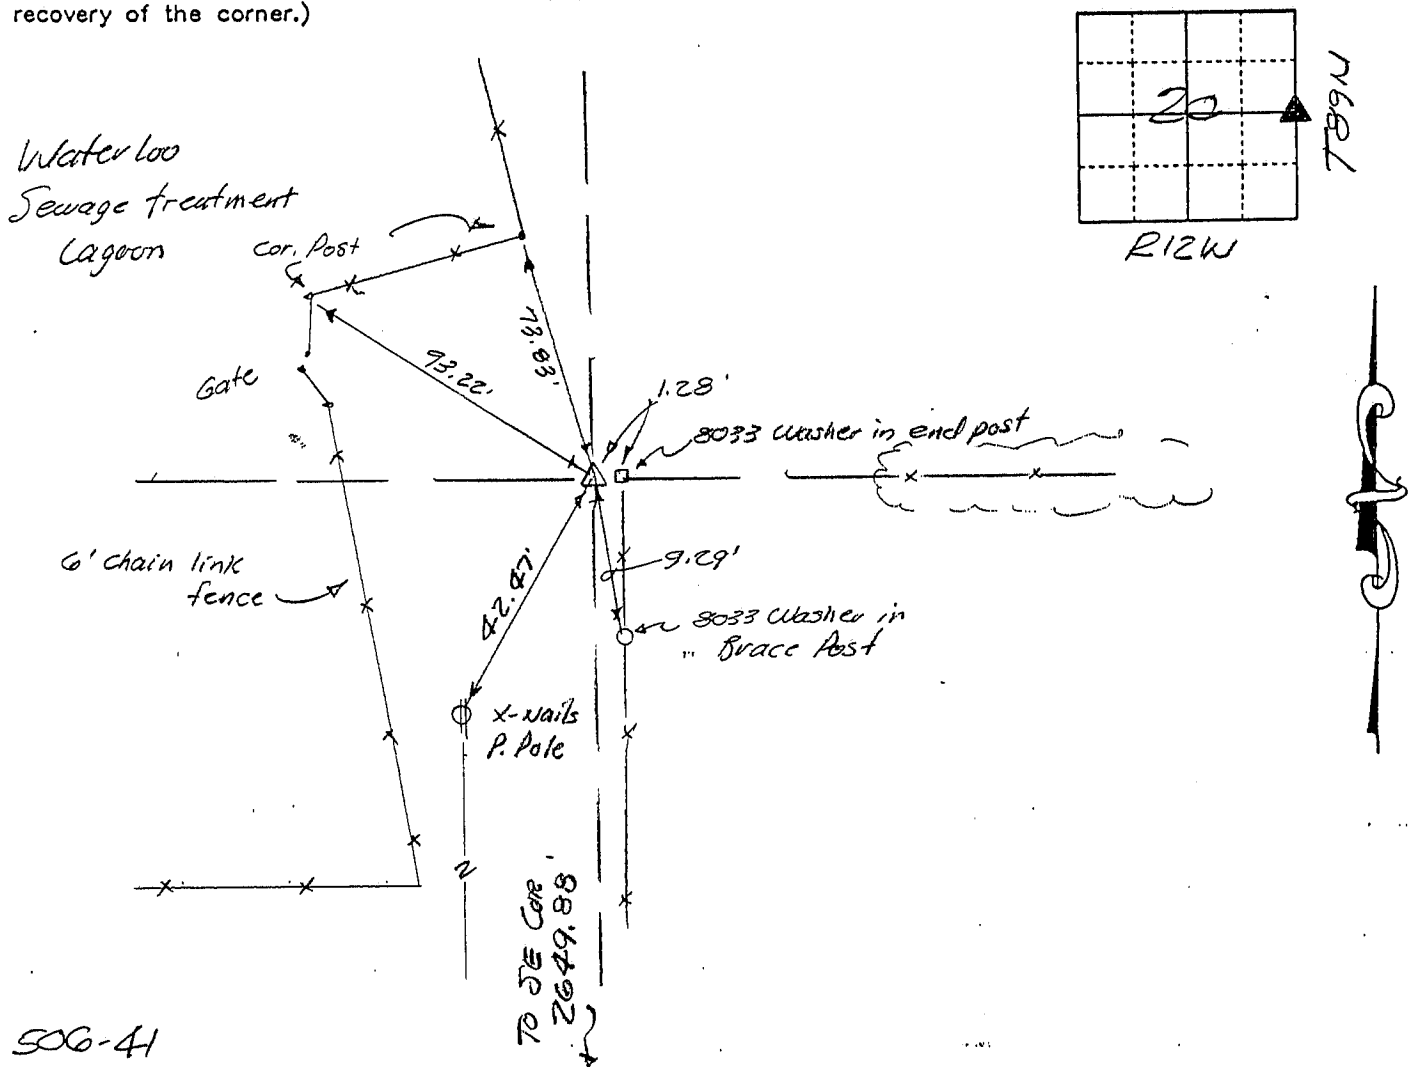


I hereby certify that the survey work was completed and this certificate was prepared by me or under my direct personal supervision and that I am a duly licensed land surveyor under the laws of the state of Iowa.

Signature: F. William King
(Name typed or printed:) F. William King
Date: Aug 3, 1999 Lic. No. 8033

List Corners to be Indexed

Corners	Section	Twp	Range
<u>E 1/4</u>	<u>20</u>	<u>39N</u>	<u>12W</u>

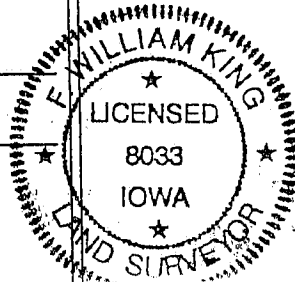

BOOK **335** PAGE **427**