

Recorded

SLSI 7-90

UNITED STATES PUBLIC LAND SURVEY CORNER CERTIFICATE
OF


Land Survey Monuments situated in Section 20, Township 89 N., Range 12 W., of the Fifth Principal Meridian, BLACK HAWK County, Iowa.
Previously recorded in Book _____, Page _____.

(Show reason for preparing this certificate, the evidence and detailed procedures used in establishing the corner positions and monumentation found or placed.)

Monument Description and Remarks: FOUND LEAD Plug WITH 'X' CUT IN CENTERLINE
NEWELL ST.

PLAN - VIEW


(Show a minimum of three reference ties to durable physical objects. relevant monuments and physical conditions that will enable recovery of the corner.)

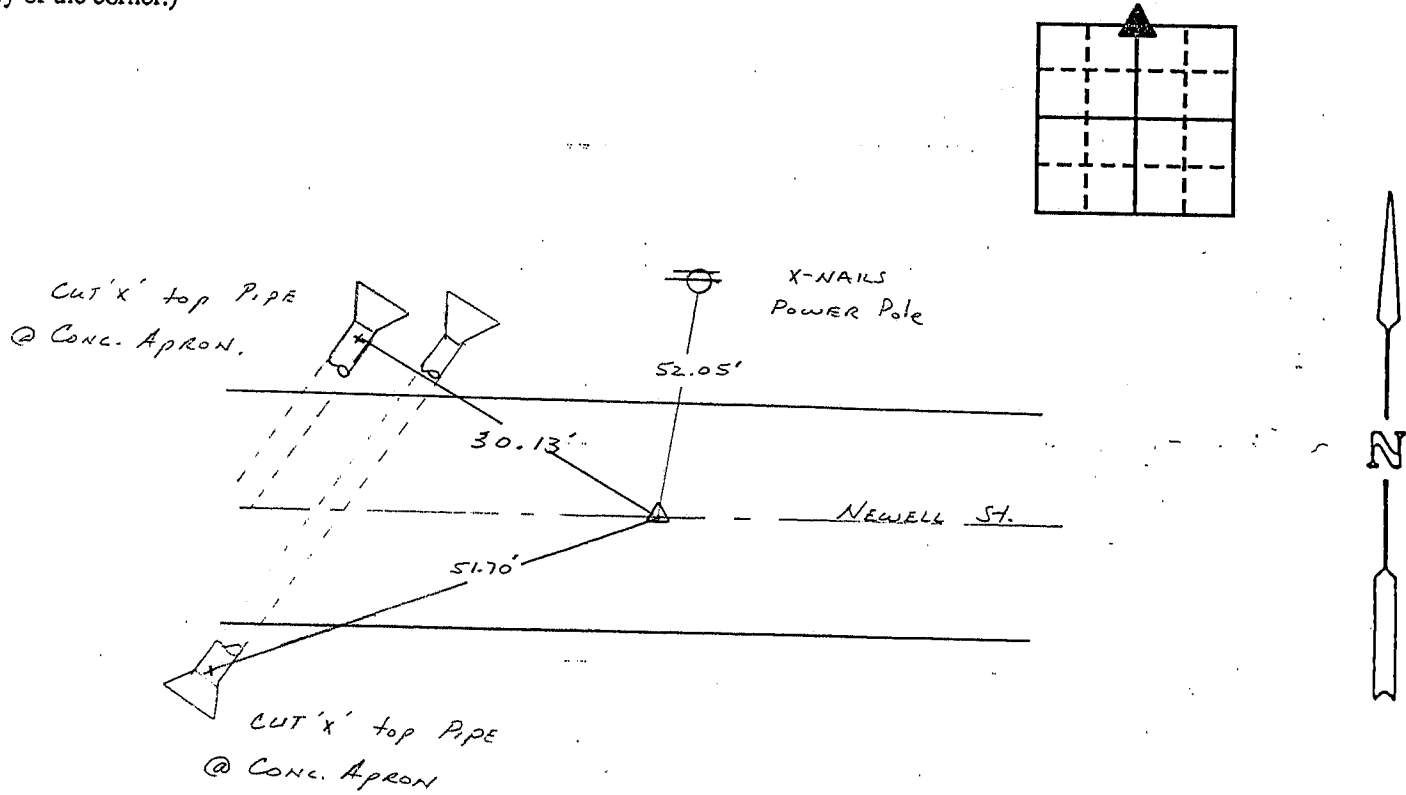

I hereby certify that the survey work was completed and this certificate was prepared by me or under my direct personal supervision and that I am a duly registered land surveyor under the laws of the state of Iowa.

Dennis R. Prange 1/6/1992
REGISTERED LAND SURVEYOR NO. 10040

SEAL

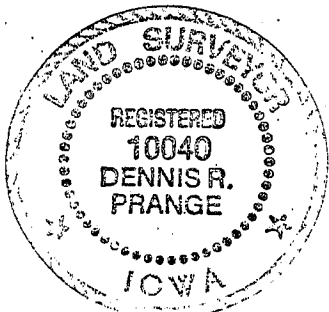

List Corners to be Indexed

Corners	Section	Twp	Range
N 1/4 Cor	20	89 N	12 W.

MISC. BK. 299 p. 393