

SC
NISC
INDEX
MARGIN
PROOF
COMPARE

BLACK HAWK COUNTY IOWA: SS
Filed for record Feb 7, 19 96 at
2:30 P.M. and recorded in Book 319
of Misc Page 540
Richard J. Lee Recorder
Fee 1-5.00x

14317

County Assessor

MICHAEL R. FAGLE, L.S. - RUST ENVIRONMENT & INFRASTRUCTURE
501 SYCAMORE ST., STE. 222, WATERLOO, IA 50703 (319)232-6531

SLSI 9-90

UNITED STATES PUBLIC LAND SURVEY CORNER CERTIFICATE

OF


Land Survey Monuments situated in Section 20, Township 89N, Range
12W, of the Fifth Principal Meridian, BLACK HAWK County, Iowa.
Previously recorded in _____ in County Recorder's Office.

(book, page, document number, etc.)
(Show reason for preparing this certificate, the evidence and detailed procedures used in establishing the corner positions and monumentation found or placed.)

Monument Description and Remarks: FOUND A CONCRETE MONUMENT WITH
BRASS CAP 18" DEEP. SET TWO IRON PINS (ONE ON EACH
SIDE OF MONUMENT), ALSO SET STEEL FENCE POST WITH
ORANGE PLASTIC CASING 0.50 FEET EAST OF MONUMENT


PLAN - VIEW

(Show a minimum of three reference ties to durable physical objects, relevant monuments and physical conditions that will enable recovery of the corner.)

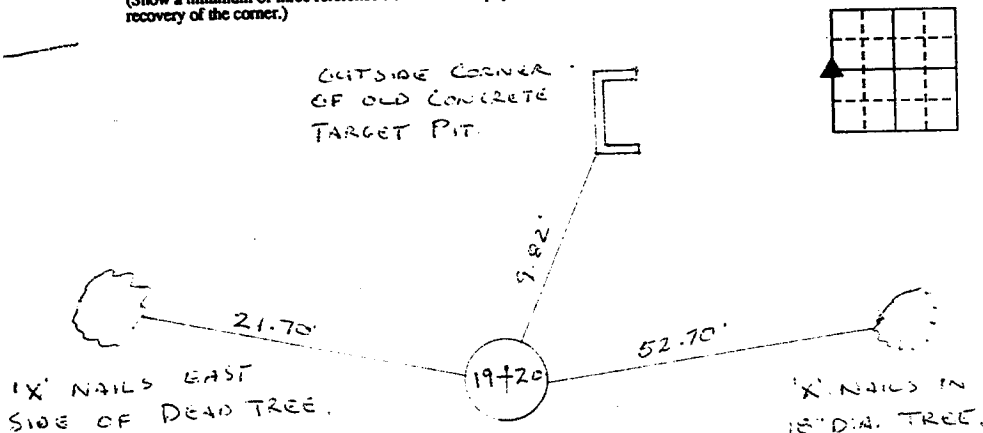

I hereby certify that the survey work was completed and this certificate was prepared by me or under my direct personal supervision and that I am a duly registered land surveyor under the laws of the state of Iowa.

Signature: Michael R Fagle
Name typed or printed: Michael R. Fagle, L.S.
Date: 2-06-96 Reg. No. 8505

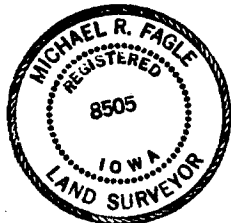

SEAL

Comers List Corners to be Indexed
Section Twp Range
W 1/4 Sec 20-789N-212W

BOOK 319 PAGE 540