

Recorded

UNITED STATES PUBLIC LAND SURVEY CORNER CERTIFICATE

OF


Land Survey Monuments situated in Section 21, Township 89 N., Range 12 W., of the Fifth Principal Meridian, BLACKHAWK County, Iowa.  
Previously recorded in Book \_\_\_\_\_, Page \_\_\_\_\_.

(Show reason for preparing this certificate, the evidence and detailed procedures used in establishing the corner positions and monumentation found or placed.)

Monument Description and Remarks: FOUND 'X' CUT IN CONCRETE. AT CENTER OF  
INTERSECTION NEWELL ST. & ELK RUN ROAD.

PLAN - VIEW

(Show a minimum of three reference ties to durable physical objects, relevant monuments and physical conditions that will enable recovery of the corner.)

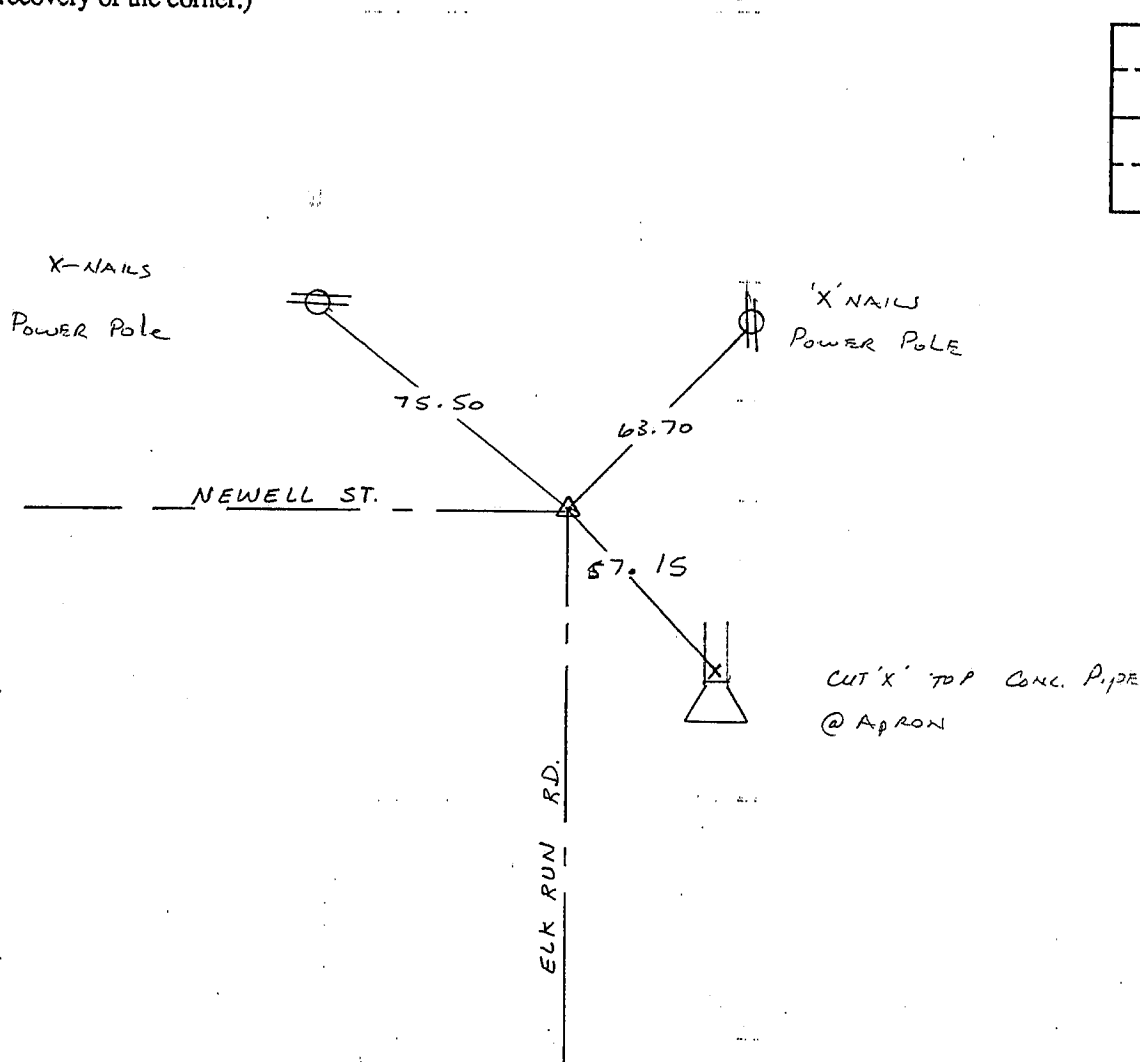


I hereby certify that the survey work was completed and this certificate was prepared by me or under my direct personal supervision and that I am a duly registered land surveyor under the laws of the state of Iowa.

Dennis R. Prange 1/6/1992

REGISTERED LAND SURVEYOR NO. 10040

SEAL

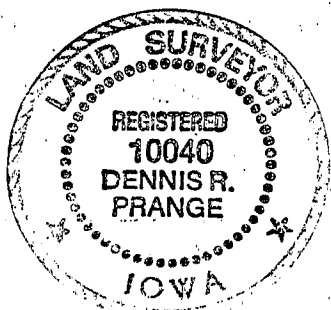

List Corners to be Indexed

Corners	Section	Twp	Range
N.E. Cor.	21	89 N.	12 W.

MISC. BK. 299 p. 401  
See also  
MISC. BK 301 p. 54