

UNITED STATES PUBLIC LAND SURVEY CORNER CERTIFICATE

OF

Land Survey Monuments situated in Section 26, Township 89N, Range 12W, of the Fifth Principal Meridian, BLACK HAWK County, Iowa.
 Previously recorded in Misc. 294-936 in County Recorder's Office.
 (book, page, document number, etc.)


(Show reason for preparing this certificate, the evidence and detailed procedures used in establishing the corner positions and monumentation found or placed.)

Monument Description and Remarks: FOUND 3/4" Ø BAR IN ASPHALT PER TIES NOTED ABOVE. ADDITIONAL TIES MADE TO ALLOW EASY RECOVERY OF THIS POINT.

(N 1/4 CORNER SEC. 26)

PLAN - VIEW

(Show a minimum of three reference ties to durable physical objects, relevant monuments and physical conditions that will enable recovery of the corner.)

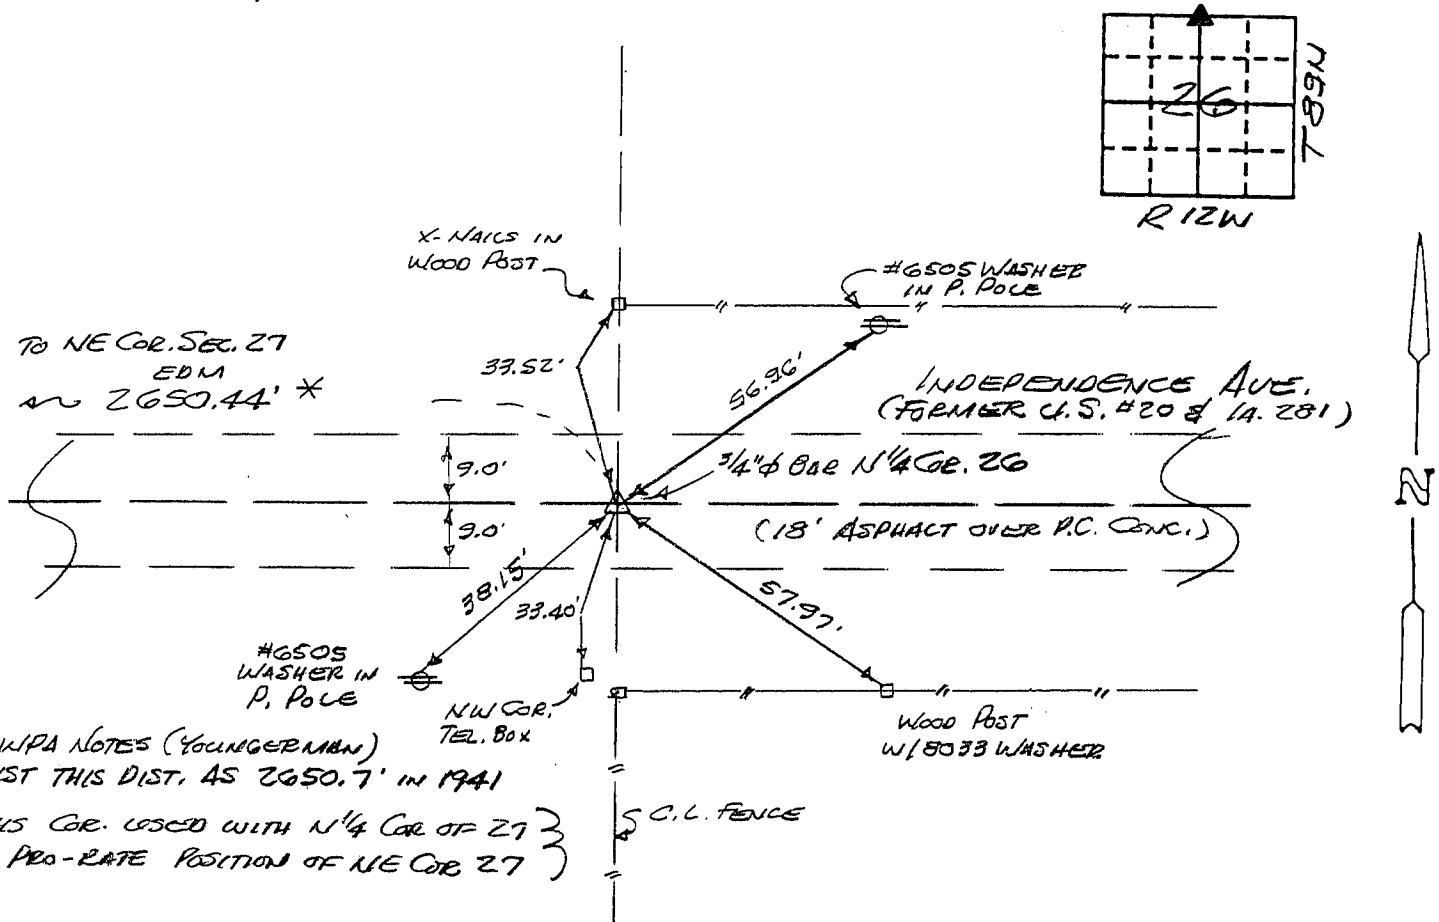

349-66

I hereby certify that the survey work was completed and this certificate was prepared by me or under my direct personal supervision and that I am a duly registered land surveyor under the laws of the state of Iowa.

Signature: F. William King

Name typed or printed: F. WILLIAM KING

Date: 3-19-1992 Reg. No. 8033



SEAL

Corners	Section	Twp	Range
N 1/4	26	89N	12W

MISC. BK. 300 p. 475