

Document Number: 2009006958

Date: Oct 01, 2008 4:30:00 pm

0.00

Aud Fee: 0.00 Trans Tax:

E-Com Fee:

Rec Fee: 0.00 0.00 Rec Management Fee:

0.00

0.00

 \mathbf{Z}

Non-Standard Page Fee: Filed for record in Black Hawk County, Iowa Judith A. McCarthy, County Recorder


BLACK HAWK COUNTY ENGINEERS OFFICE 316 E. FIFTH STREET, ROOM 211 WATE PH.# (319) 833-3008 FAX.# (319) 833-3139 * PREPARED BY: SLSI 9-94 CERT 12-96 WATERLOO, IOWA 50703

UNITED STATES PUBLIC LAND SURVEY CORNER CERTIFICATE OF

Land Survey Monuments situated in Section 26, Township 89 N Range 12 W , of the Fifth Principal Meridian, BLACK HAWK County, Iowa. Previously recorded in Misc. Book <u>294</u>, Page <u>936</u>, in County Recorder's Office. & Misc. Book <u>300</u>, Page <u>475</u>

(Show reason for preparing this certificate, the evidence and detailed procedures used in establishing the corner positions and monumentation found or placed.)

Monument Description and Remarks: FND. STL. SPIKE STAMPED "SURVEY MARKER" IN C.L. INTERSECTION HWY. 281 (E-W) & RAYMOND RD. (N-S), PER RECORD TIES IN ABOVE RECORD(S). CO. ENG. OFFICE DENOTES CORNER "RESET" FROM RECORD TIES ON DEC. 4, 1998 DUE TO RECORD P.K. NAIL BEING DESTROYED FROM IA. DOT A.C.C. RESURFACING PROJECT THRU INTERSECTION (E-W). <u>B.H.</u> CO. ENG. FIELD NOTES STATE "RESET 3" STEEL SURVEY MARKER SPIKE PER RECORD CORNER CERT. TEMP. REFERENCED CORNER FOR INTERSECTION RECONSTRUCTION PROJECT 2008, PER RTK <u>GPS. EXCAVATED 2'0×18"Dp. @ LOCATION AFTER PAVEMENT REMOVAL, & FOUND NO FURTHER</u> SET CUT "X" IN PCC PAVEMENT, N.E. QUAD OF ROUNDABOUT INTERSECTION, PER CORNER EVIDENCE. TEMP. GEOM. REF. & RE-TIED AS DENOTED. REFER TO ACQUISITION PLATS FOR R/W AT BOTH N.W. & S.E. CORNER'S OF INTERSECTION FOR ADDITIONAL GEOMETRIC SECTION-LINE DETAILS.

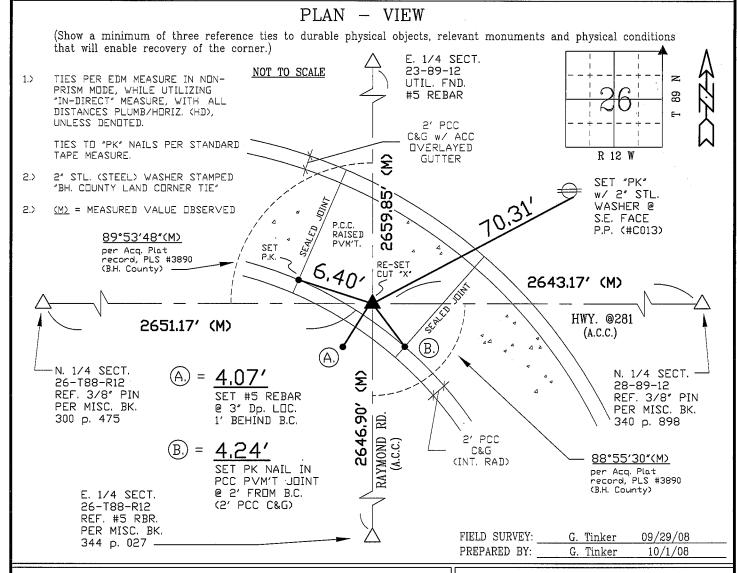



I hereby certify that this land surveying document was prepared and the related survey work was performed by me or under my direct personal supervision and that I am a duly licensed Land Surveyor under the laws of the State of Iowa.

2008

15748

ALLEN

TINKER

15748

AWOI

My license renewal date is December 31, 2008

Pages or sheets covered by this seal:

This Land Corner Certificate Only.

LIST CORNERS TO BE INDEXED

Corner	<u>Section</u> -	<u>Township</u>	- <u>Range</u>
N.E. Cor.	26	89 N	12 W
S.E. Cor.	23	89 N	12 W
N.W. Cor.	25	89 N	12 W
S.W. Cor.	24	89 N	12 W