



Doc ID: 006802960001 Type: GEN
Recorded: 07/02/2015 at 08:54:51 AM
Fee Amt: \$7.00 Page 1 of 1
Black Hawk County Iowa
SANDIE L. SMITH RECORDER

File 2016-0000019C

PREPARED BY / RETURN TO: KENNETH D. STARK IOWA DEPARTMENT OF TRANSPORTATION 1420 4th ST. SE MASON CITY, IA 50401 641-423-7584

ENV UNITED STATES PUBLIC LAND SURVEY CORNER CERTIFICATE
OF

Land Survey Monuments situated in Section 27, Township 89N, Range 12W
of the Fifth Principal Meridian, BLACK HAWK County, Iowa.

Previously recorded in BOOK 301, PAGE 58 & MISC BOOK 300, PAGE 471 in County Recorder's Office.
(book, page, document number, etc.)


(Show reason for preparing this certificate, the evidence and detailed procedures used in establishing the corner positions and monumentation found or placed.)

Monument Description and Remarks: NW COR = FOUND ALUMINUM DISC ON IA. 281 & ELK RUN ROAD PER PREVIOUS CERT BOOK 301, PAGE 58. REASON FOR CERT: NO LONGER 3 REMAINING REFERENCE TIES.

N 1/4 COR = REPLACED PREVIOUSLY FOUND P-K NAIL WITH SURVEY MARK NAIL & IDOT 10898 WASHER 0.4' NORTH OF IA. 281 IN ACC PAVEMENT AFTER 2012 OVERLAY PROJECT STP-281-1(45)--2C-07 PER PREVIOUS CERT MISC. BOOK 300, PAGE 471.
REASON FOR CERT: CHANGE TO MONUMENT

PLAN - VIEW

(Show a minimum of three reference ties to durable physical objects, relevant monuments and physical conditions that will enable recovery of the corner.)

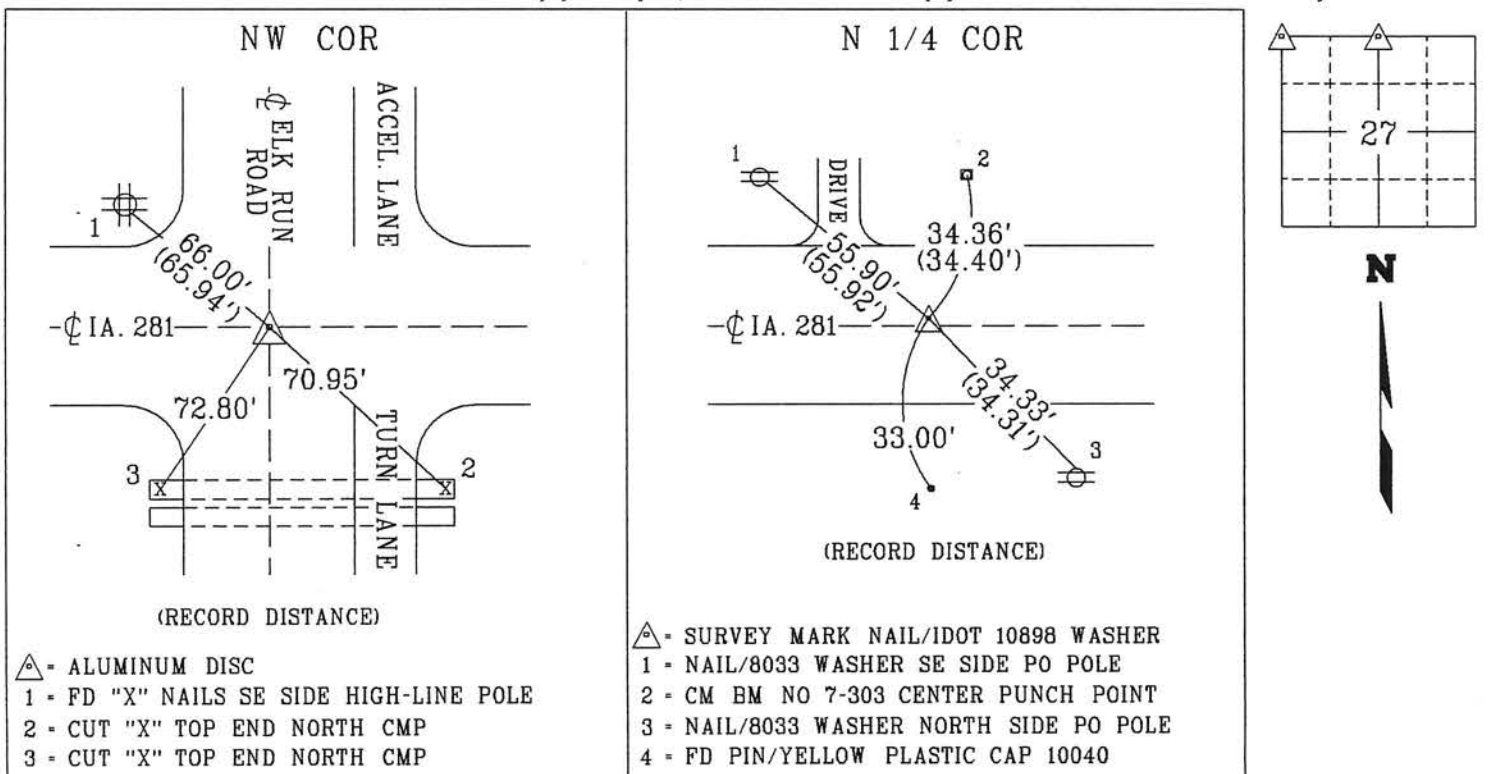

PROFESSIONAL LAND SURVEYOR
KENNETH D. STARK
10898
IOWA

I hereby certify that this land surveying document was prepared and the related survey work was performed by me or under my personal supervision and that I am a duly licensed Land Surveyor under the laws of the state of Iowa.
Kenneth D. Stark Date 08-15-15
Kenneth D. Stark
License number 10898
My License renewal date is December 31, 2015
Pages or sheets covered by this seal. 1

List Corners to be Indexed

Corner	Section	Township	Range
NW CORNER	27	89N	12W
N 1/4 CORNER	27	89N	12W

TIED:ME/CS DRAWN:ME

07-27-89-12

700

1