

Recorded

SLSI 9-90

UNITED STATES PUBLIC LAND SURVEY CORNER CERTIFICATE

OF


Land Survey Monuments situated in Section 27, Township 89N, Range R12W, of the Fifth Principal Meridian, BLACK HAWK County, Iowa.
Previously recorded in N/A (book, page, document number, etc.) in County Recorder's Office.

(Show reason for preparing this certificate, the evidence and detailed procedures used in establishing the corner positions and monumentation found or placed.)

Monument Description and Remarks: SET P-K NAIL IN ASPHALT PAVING AT E SLAB
AND W.P.A. PRO-RATA DISTANCE BETWEEN N¹/₄ SEC. 26 & N¹/₂ COR. 27.
YOUNGERMAN 1941 NOTES CALL FOR 2661.2' NO. LN. NE¹/₄ 27 & 2650.7
NO. LN. NW¹/₄ 26. 1941 CORNER WAS SET ON E OF 18' CONC. SLAB WHICH
STILL EXISTS (1992) WITH A-C OVERLAY.

PLAN - VIEW

(Show a minimum of three reference ties to durable physical objects, relevant monuments and physical conditions that will enable recovery of the corner.)

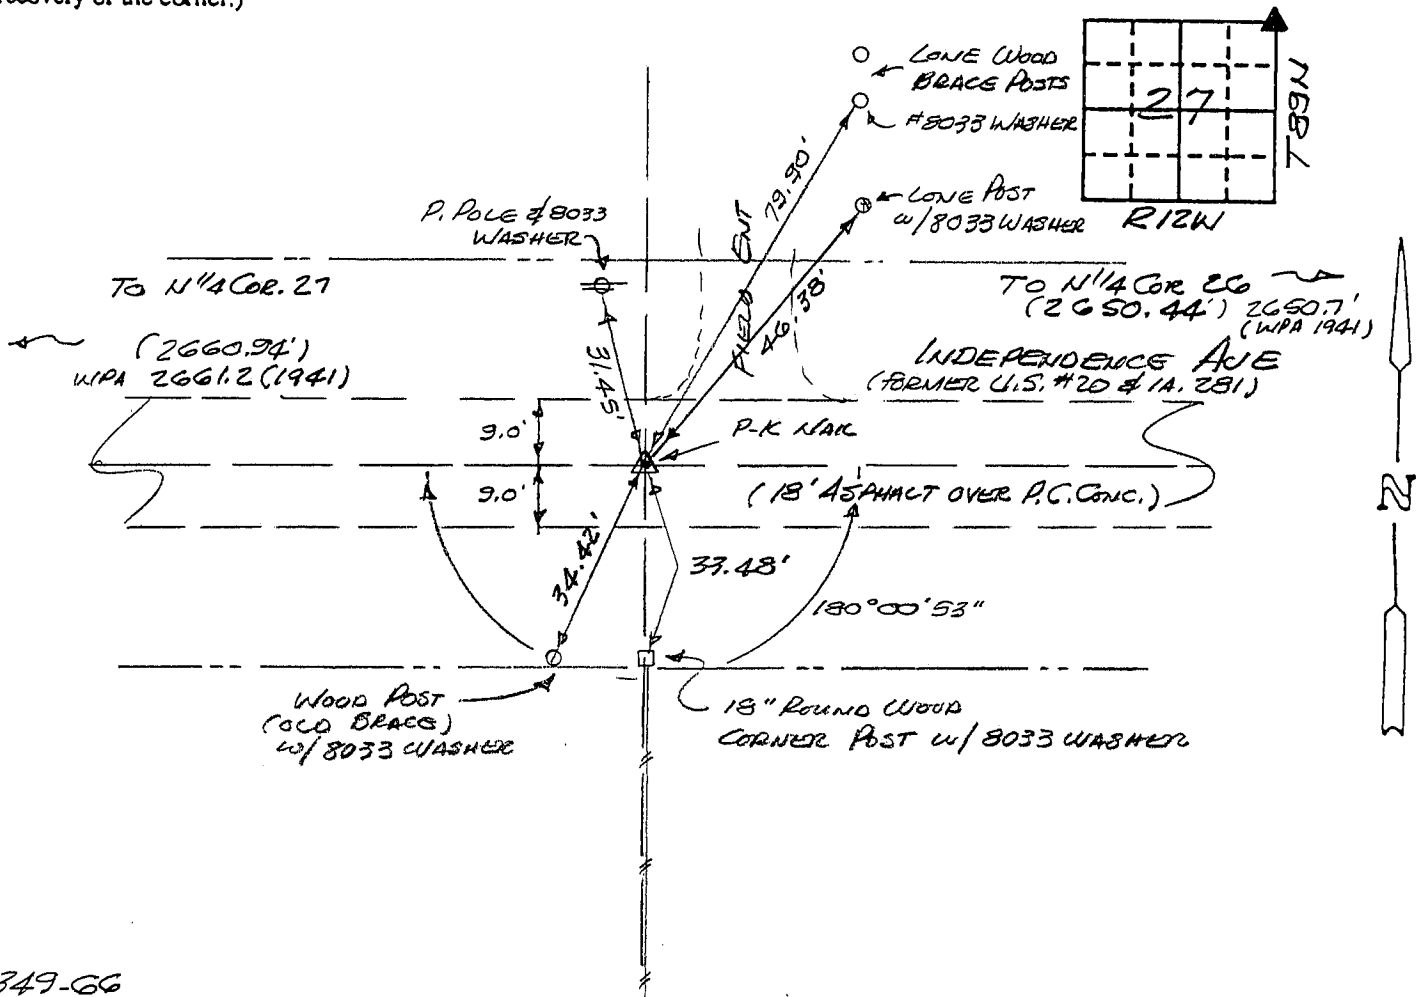

349-66

I hereby certify that the survey work was completed and this certificate was prepared by me or under my direct personal supervision and that I am a duly registered land surveyor under the laws of the state of Iowa.

Signature: F. William King

Name typed or printed: F. WILLIAM KING

Date: 3-19-1992 Reg. No. 8033

Corners	List Corners to be Indexed	Section	Twp	Range
NE	27	89N	12W	

SEAL



MISC. BK. 300 p. 473