


SLSI 9-94
BHCO 03-09


Monument Description and Remarks: CENTER: FOUND RECORD CORNER (1/2" RBR.) BENT OVER AND DISTURBED DUE TO REMOVAL OF TREE'S & FENCE LINE @ LOCATION (AREA NOW AGRIC. CROPS). REF. TO LAND COR. GEOM. PER PLAT OF SURVEY IN MISC. BK. 328 p.297 TO CALC. CORNER, AND RESET PER INDIRECT MEAS. OF N. 1/4 & E. 1/4 CORNERS AND VERIFIED (±) WITH C.E. 1/16th CORNER. CORNER RESET w/ 5/8" REBAR x 30"L. w/ ROCK (AGG.) BURIED ON S. SIDE OF CORNER, WITH WITNESS CORNER'S SET TO N./S./E. DIR.'S & ON 1/4 LINES (PER DETAIL). C.E.1/16th COR: FOUND #4 (1/2") REBAR w/PLASTIC CAP #6505 ALONG w/T-POST, PER PLAT OF SURVEY IN MISC. BK. 328 p.297. CORNER NOT OF CURRENT RECORD, AND FILED w/ REFERENCE TO BELOW LAND LINE GEOM., AS OBSERVED. "NO" PLANIMETRIC TIES AVAIL., SO REF. GEOM. TO LAND CORNERS AS DENOTED.

FIELD BOOK: TopSurv "OsageRd ROW" Proj.

T 89 N

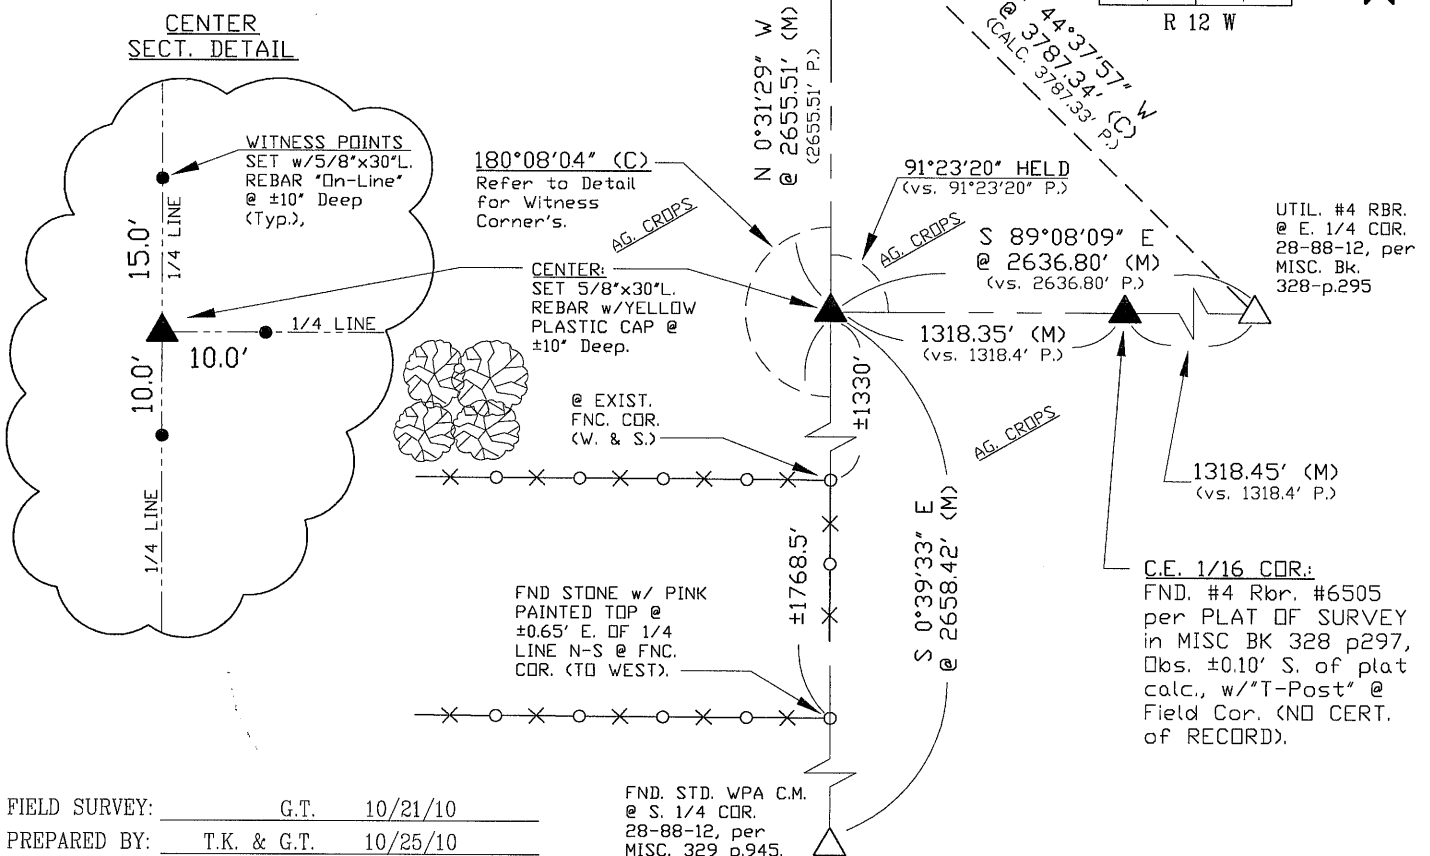

<u>Corner</u>	<u>Section</u> -	<u>Township</u> -	<u>Range</u>
CENTER	28	89 N	12 W
C.E. 1/16th	28	89 N	12 W

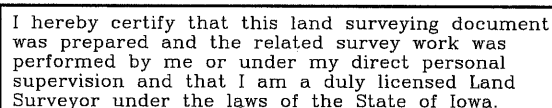

Geoffrey Allen Tinker 10/25/2010
(date)

License Number 15748

My license renewal date is December 31, 2010

Pages or sheets covered by this seal:

This Land Corner Certificate Only.

INDEX OF ABBREVIATIONS

(M) = "Measured" Dimension	"NP" = Reflectless EDM Meas.
(P) = "Platted" Dimension	"MLM" = Indirect Measure
(R) = "Record" Dimension	"CM" = Concrete Monument
(C) = "Calculated" Dimension	"SM" = Survey Marker Spike/Tag
"IGS" = Iowa Geodetic Survey	"PK" = PK/MAG Nail Brand Style
"WPA" = Works Progress Admin. Survey	
"G" = per George Miller Survey (BHCo Surveyor 1858-1860)	
"B" = per John Ball Survey (BHCo Surveyor 1866-1891)	
"N" = per Nathan Barber Survey (BHCo Surveyor 1906-1931)	