

Misc

BLACK HAWK COUNTY IOWA:SS 10556  
FILED FOR RECORD Dec 2 1997 AT  
3:00 P.M., AND RECORDED IN BOOK 328  
OF Misc PAGE 295  
FEE 1-5.00/ RECORDER  
PAUL HELLAND

PAUL H. HELLAND, 1107 TECHNOLOGY PARKWAY, CEDAR FALLS, IOWA 50613, (319)-266-0161

# UNITED STATES PUBLIC LAND SURVEY CORNER CERTIFICATE OF

LAND SURVEY MONUMENTS SITUATED IN SECTION NO. 28, TOWNSHIP NO. 89N, RANGE NO. 12W, OF THE FIFTH PRINCIPAL MERIDIAN, BLACK HAWK COUNTY, IOWA.  
PREVIOUSLY RECORDED IN BOOK PAGE

(SHOW REASON FOR PREPARING THIS CERTIFICATE, THE EVIDENCE AND DETAILED PROCEDURES USED IN ESTABLISHING THE CORNER POSITIONS AND MONUMENTATION FOUND OR PLACED.)

## MONUMENT DESCRIPTION AND REMARKS:

SURVEY DONE IN SE 1/4 NE 1/4 SEC. 28-89-12


N 1/4 CORNER - ALL COUNTY TIES WERE GONE, SET MAG NAIL IN A.C.C. PAVEMENT AS YOUNGERMAN DID IN 1941 AT CENTERLINE OF SLAB IN LINE W/FENCE SOUTH

E 1/4 CORNER - FOUND NO. 4 REBAR IN CENTERLINE OF A.C.C. PAVEMENT AT COUNTY TIES.

CENTER - FOUND EVIDENCE OF ORIGINAL CORNER POST & FENCE LINE, DUG HOLE & PROBED FOR STONE, NO STONE FOUND, SET NO. 4 REBAR W/CAP #6505

## PLAN VIEW

(SHOW A MINIMUM OF THREE REFERENCE TIES TO DURABLE PHYSICAL OBJECTS, RELEVANT MONUMENTS AND PHYSICAL CONDITIONS THAT WILL ENABLE RECOVERY OF THE CORNER.)

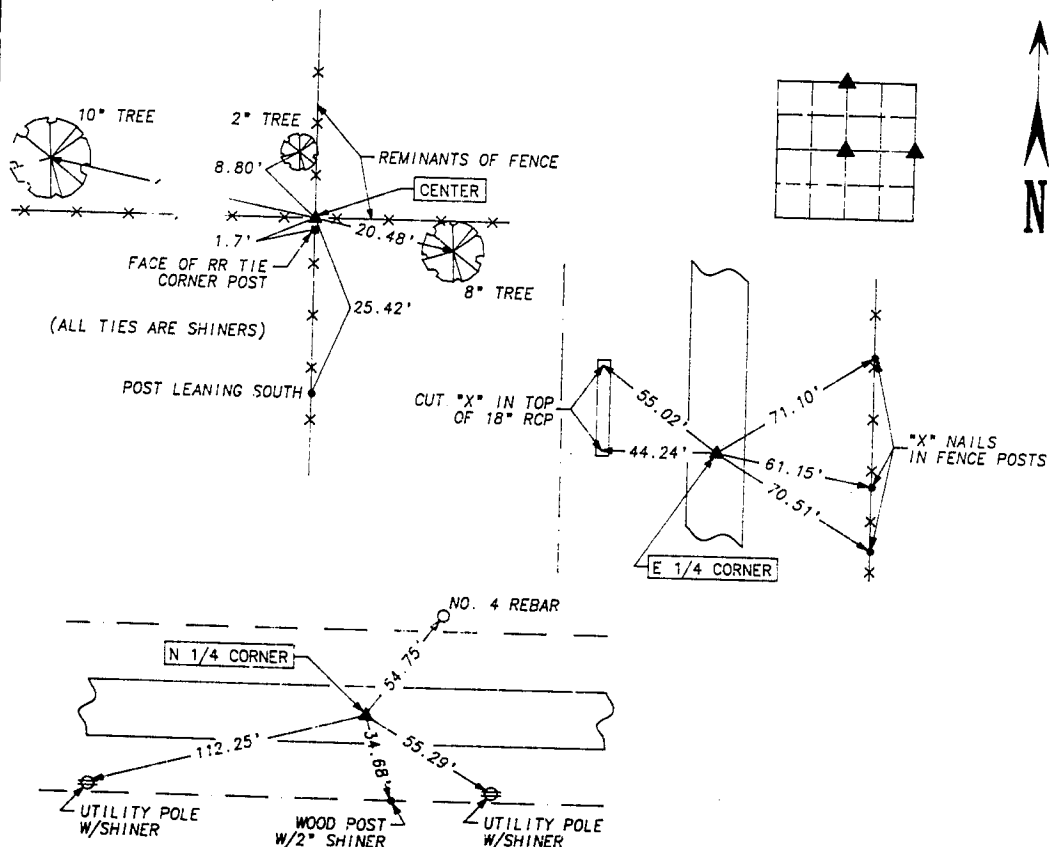

I HEREBY CERTIFY THAT THIS PLAT, MAP, SURVEY OR REPORT WAS MADE BY ME OR UNDER MY DIRECT PERSONAL SUPERVISION AND THAT I AM A DULY REGISTERED LAND SURVEYOR UNDER THE LAWS OF THE STATE OF IOWA  
DATE 12/21/97  
PAUL H. HELLAND, P.E. & R.L.S. IOWA REGISTRATION NO. 6505  
MY REGISTRATION EXPIRES DECEMBER 31, 1997




HELLAND ENGINEERING  
& SURVEYING, LTD.  
1107 TECHNOLOGY PARKWAY  
CEDAR FALLS, IOWA 50613  
319-266-0161




LIST CORNERS TO BE INDEXED			
CORNER	SECTION	TOWNSHIP	RANGE
N 1/4	28	89N	12W
E 1/4	28	89N	12W
CENTER	28	89N	12W

BOOK 328 PAGE 295

PAUL H. HELLAND, P.E. & R.L.S. IOWA REGISTRATION NO. 6505  
MY REGISTRATION EXPIRES DECEMBER 31, 1997

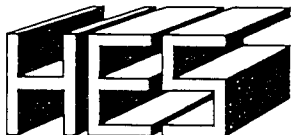

HELLAND ENGINEERING  
& SURVEYING, LTD.  
1107 TECHNOLOGY PARKWAY  
CEDAR FALLS, IOWA 50613  
319-266-0161

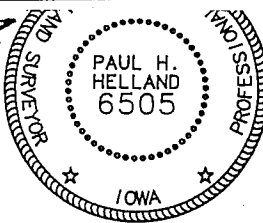

N 1/4	28	89N	12W
E 1/4	28	89N	12W
CENTER	28	89N	12W