

SC
MISC
INDEX
MARGIN
PROOF
COMPARE

008453
BLACK HAWK COUNTY IOWA:SS
FILED FOR RECORD OCT 20, 2000 AT
11:30 A.M. AND RECORDED IN BOOK 340
OF MISC PAGE 645
William S. King RECORDER
FEE 1-5.00/
WAYNE CLAASSEN ENGINEERING & SURVEYING INC.

WAYNE CLAASSEN ENGINEERING AND SURVEYING, INC.
P.O. BOX 898 WATERLOO, IOWA 50704-0898

PHONE: (VOICE) 319-235-6294
(FAX) 319-235-0028

UNITED STATES PUBLIC LAND SURVEY CORNER CERTIFICATE


and Survey Monuments situated in Section 29, Township 89N, Range 12W, of the Fifth Principal Meridian, Black Hawk County, Iowa.
Previously recorded in N/A in County Recorder's Office.
(book, page, document number, etc.)

(Show reason for preparing this certificate, the evidence and detailed procedures used in establishing the corner positions and monumentation found or placed.)

Monument Description and Remarks FOUND SOLID 1/2" Ø PIN 20" DEEP PER AUDITOR
RAINBOWS PLAT OF MAYWOOD 2ND FILING (1909). (W 1/4 CORNER)

PLAN - VIEW

(Show a minimum of three reference ties to durable physical objects, relevant monuments and physical conditions that will enable recovery of the corner.)

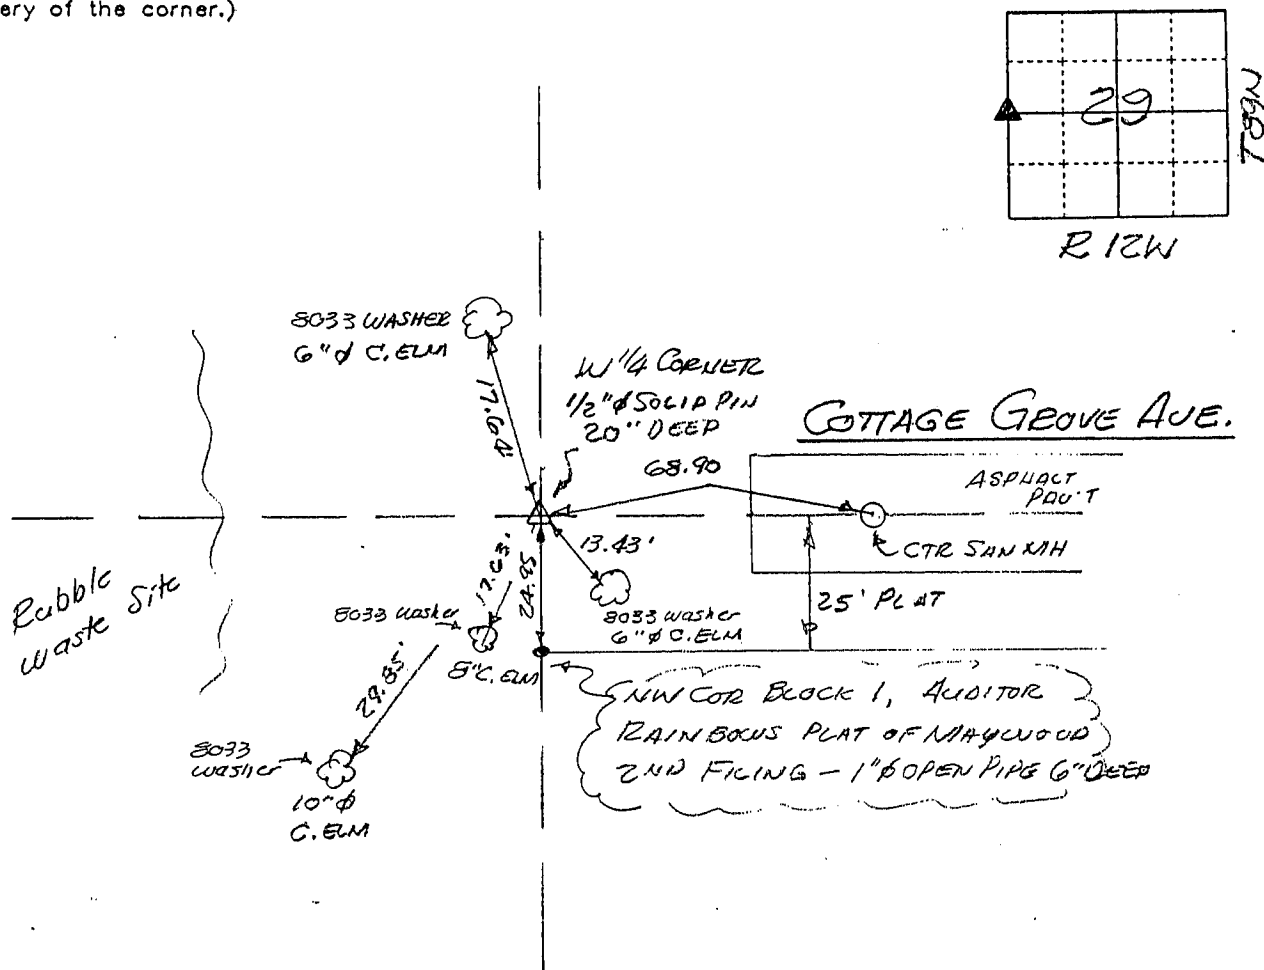

518-12

I hereby certify that the survey work was completed and this certificate was prepared by me or under my direct personal supervision and that I am a duly licensed land surveyor under the laws of the state of Iowa.


Signature: *F. William King*
(Name typed or printed:) F. WILLIAM KING

Date: OCT 19, 2000 Lic. No. 8033

SEAL

List Corners to be Indexed

Corners	Section	Twp	Range
W 1/4	29	89N	12W

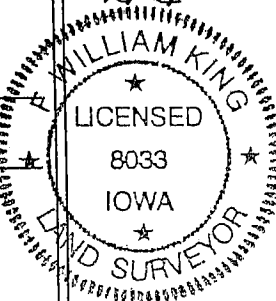

BOOK 0340 PAGE 645