

Doc ID: 004573230001 Type: GEN
 Kind: CORNER
 Recorded: 09/12/2011 at 01:03:54 PM
 Fee Amt: \$7.00 Page 1 of 1
 Black Hawk County Iowa
 JUDITH A MCCARTHY, RECORDER
 File **2012-00004493**

Recorded By: Michael R. Fagle, P.L.S.

AECOM, 501 Sycamore St., Suite 222, Waterloo, Iowa 50703

1-319-232-6531

UNITED STATES PUBLIC LAND SURVEY CORNER CERTIFICATE OF

Land Survey Monuments situated in Section 35, Township 89 North, Range 12 West, of the Fifth Principal Meridian, Black Hawk County, Iowa. Previously recorded in ** See Book and Page below.
 in County Engineer's Office. (Book, Page, Document Number, etc.)

(Show reason for preparing this certificate, the evidence and detailed procedures used in establishing the corner positions and monumentation found or placed.)

Monument Description and Remarks: Found Standard Concrete Monument at the North 1/4 corner of Section 35, Township 89 North, Range 12 West of 5th P.M., after the Black Hawk County Osage Road Improvements Project L-0913--73-07) was completed, which required 19" of granular and hot mix asphalt, a 1/2" x 24" rebar was set with a yellow plastic cap no. 8508.


PLAN - VIEW

(Show a minimum of three reference ties to durable physical objects, relevant monuments and physical conditions that will enable recovery of the corner.)

** Iowa Geodetic Survey Book 2--T89-R12 Page 32
 in the Black Hawk County Engineer's Office

TOP CENTER END
C.M.P. AT DRIVEWAY


TOP CENTER END
C.M.P. AT DRIVEWAY

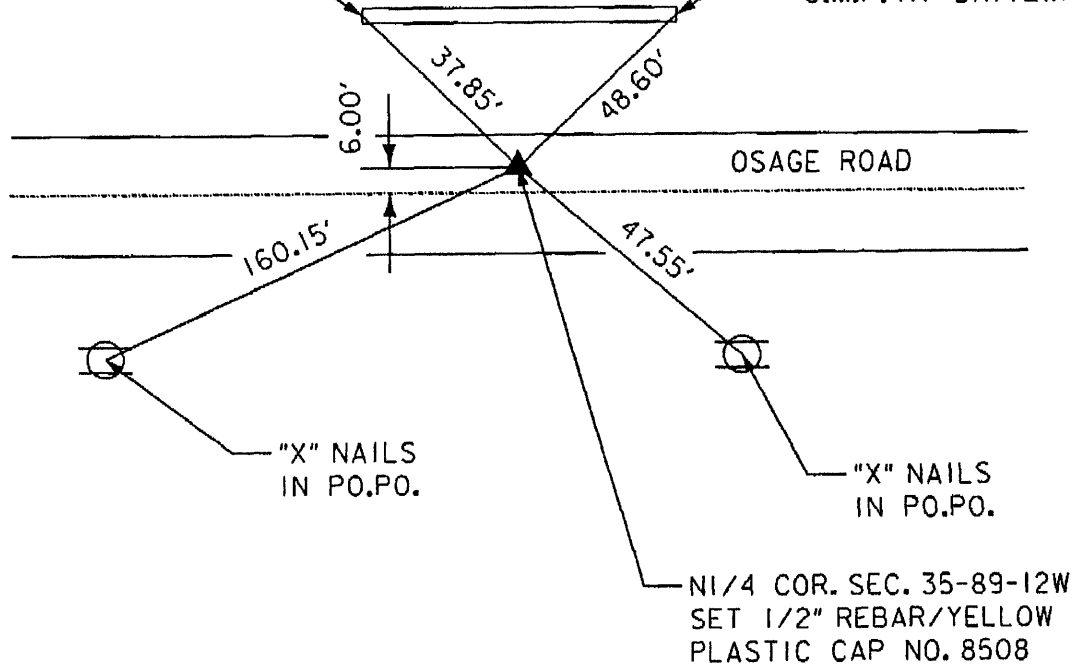

"X" NAILS
IN P.O.P.O.

"X" NAILS
IN P.O.P.O.

N1/4 COR. SEC. 35-89-12W
SET 1/2" REBAR/YELLOW
PLASTIC CAP NO. 8508

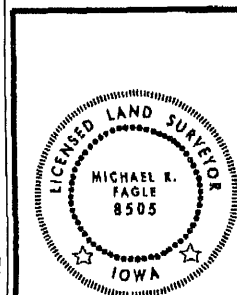

I hereby certify that this Land Surveying document was prepared by me or under my direct personal supervision and that I am a duly Licensed Land Surveyor under the laws of the State of Iowa.

Michael R. Fagle 9-06-2011
 MICHAEL R. FAGLE Date

License number 8505

My license renewal date is December 31, 2012

Pages or sheets covered by this seal:

THIS SHEET

List Corners to be Indexed

Corners	Section	Twp	Range
North 1/4 Corner	35	T 89 N	R 12 W