

INDEX

BLACK HAWK COUNTY, IOWA:SS

FEE BOOK # 2006 3422

PROOF

FILED FOR RECORD AUG 5 2005 AT 11:00 A.M. FEE 1-5.00-1.00/

COMPARED

Patricia S. Jess

BLACK HAWK COUNTY RECORDER

KESS & ASSOCIATES INC

Kirk D. Eschliman, P.L.S. Iowa Lic. No. 9961, 723 Broadway Street, Waterloo, Iowa 50703 - Phone: 319-234-0509

UNITED STATES PUBLIC LAND SURVEY CORNER CERTIFICATE
OFLAND SURVEY MONUMENTS SITUATED IN SECTION THIRTY-FIVE (35), TOWNSHIP EIGHTY-NINE (89) NORTH
RANGE TWELVE (12) WEST, OF THE FIFTH PRINCIPAL MERIDIAN, BLACK HAWK COUNTY, IOWA.
PREVIOUSLY RECORDED IN (NOT PREVIOUSLY RECORDED) (BOOK, PAGE, DOCUMENT NUMBER, ETC.) IN THE COUNTY RECORDER'S OFFICE.


(SHOW REASON FOR PREPARING THIS CERTIFICATE, THE EVIDENCE AND DETAILED PROCEDURES USED IN ESTABLISHING THE CORNER POSITIONS AND MONUMENTATION FOUND OR PLACED.)

MONUMENT DESCRIPTION AND REMARKS:

CURRENT SECTION CORNER CERTIFICATE NOT ON FILE IN THE BLACK HAWK COUNTY ENGINEER'S OFFICE

FOUND P.K. NAIL AT THE SURFACE OF ASPHALT SURFACED NORTH THIRD STREET.

(CURRENT LOCATION AGREES WITH W.P.A. REFERENCE SURVEY NOTES)

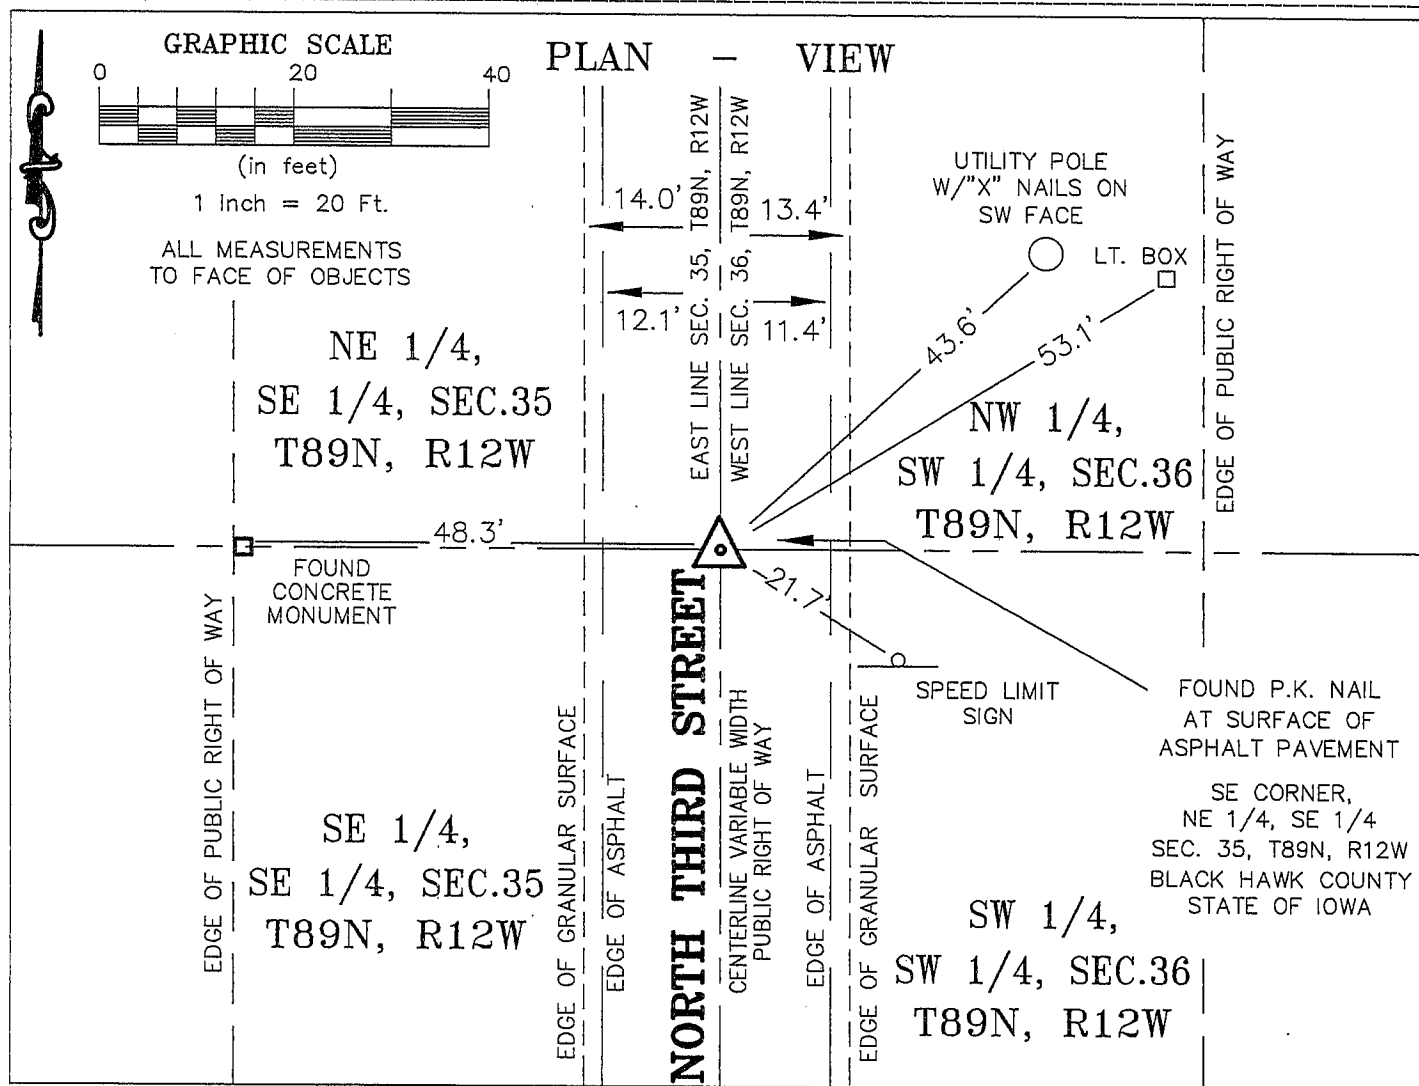I HEREBY CERTIFY THAT THIS LAND SURVEYING DOCUMENT
WAS PREPARED AND RELATED SURVEY WORK WAS
PERFORMED BY ME OR UNDER MY DIRECT PERSONAL
SUPERVISION AND THAT I AM A DULY LICENSED LAND
SURVEYOR UNDER THE LAWS OF THE STATE OF IOWA.*Kirk D. Eschliman*

DATE: 08/03/2005


KIRK D. ESCHLIMAN, P.L.S. IOWA LIC. NO. 9961
MY LICENSE RENEWAL DATE IS DECEMBER 31, 2005
PAGES OR SHEETS COVERED BY THIS SIGNATURE & SEAL: SHEET 1 OF 1FOR: GARY J. & BARBARA A. SCHMITZ
5903 CONRAD ROAD
WATERLOO, IOWA 50703REQ. BY: GARY J. SCHMITZ
WATERLOO, IOWAKESS & ASSOCIATES, INC.
PROFESSIONAL LAND SURVEYORS - 723 BROADWAY, WATERLOO, IOWA 50703-5811
DATE: 8/03/2005 C.A.D.D. FILE: 03B68SCC1.DWG PROJECT NO.: 03B68

List of corners to be indexed:

Corner	Section	Township	Range
SE COR, NE 1/4, SE 1/4	35	T89N	R12W

R12W

T89N

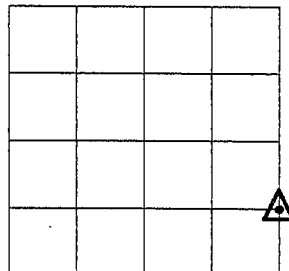

SECTION 35