

Doc ID: 004157510001 Type: GEN Kind: CORNER Kind: CORNER
Recorded: 06/02/2010 at 02:00:50 PM
Fee Amt: \$0.00 Page 1 of 1
Black Hawk County Iowa
JUDITH A MCCARTHY RECORDER

File 2010-00022578

X PREPARED BY:

BLACK HAWK COUNTY ENGINEERS OFFICE 316 E. FIFTH STREET, ROOM 211 WATE

WATERLOO, IOWA 50703

PH.# (319) 833-3008 FAX.# (319) 833-3139

SLSI 9-94 BHC0 03-09

UNITED STATES PUBLIC LAND SURVEY CORNER CERTIFICATE OF Land Survey Monuments situated in Section______, Township___89 N____ Range 12 W , of the Fifth Principal Meridian, BLACK HAWK County, Iowa. Previously recorded in Misc. Book N/A, Page N/A, in County Recorder's Office. (Show reason for preparing this certificate): There is No Certificate for the corner on file with County Recorder, per Ia. Code 355.11(1)(a).

(Evidence and detailed procedures used in establishing the corner position(s) and monumentation found or placed.) S 1/4 CDR. Monument Description and Remarks:

UTIL. FND. 1" D.D. GAS PIPE @ -2" Dp. BETWEEN R.R. AND DUBUQUE RD., WITH CORNER USED AS PART OF "PLAT OF SURVEY" IN E. 1/2 OF THE S.W.1/4 OF SAID SECTION 36. CORNER REFERENCED AS "FOUND" PER MISC. 170 p.189 (Dtd. JAN. 1967, per PLS #3362).

ALL DISTANCES PLUMB/HORIZ. (H.D.), "UNLESS DENOTED".

PLAN VIEW


BHco Hist Ties:

- NONE -

"NOT TO SCALE"


FIELD BOOK: BHco. #489 p.10

(Show a minimum of three reference ties to durable physical objects, relevant monuments and physical conditions that will enable recovery of the corner.)

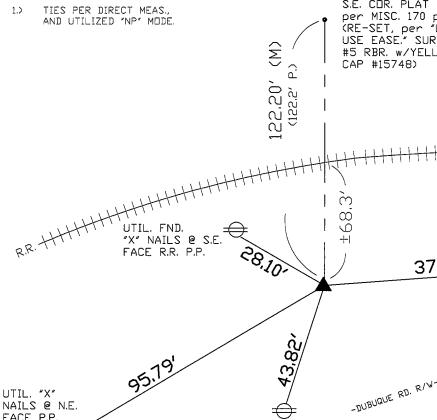

S.E. COR. PLAT per MISC. 170 p.189 (RE-SET, per "LAND USE EASE." SURVEY, #5 RBR. W/YELLOW CAP #15748)

37.18′

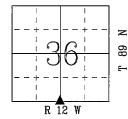

SET PK/WASHER @ S. FACE TREE CLUSTER @ 1.9'

FIELD SURVEY: _ G.T. & C.W. PREPARED BY G.T. & T.K

<u>CERTIFICATION</u>



FACE P.P

I hereby certify that this land surveying document was prepared and the related survey work was performed by me or under my direct personal supervision and that I am a duly licensed Land Surveyor under the laws of the State of Iowa.

FND L.S. TAG #12088 @ N. FACE P.P.

06/02/2010

15748 License Number

My license renewal date is December 31, 2010

Pages or sheets covered by this seal:

This Land Corner Certificate Only.

LIST CORNERS TO BE INDEXED

<u>Corner</u> <u>Section</u> – Township -Range S. 1/4 Cor. 89 N 12 W 36

INDEX OF ABBREVIATIONS

"NP" = Reflectorless EDM Meas.
"MLM" = Indirect Measure
"CM" = Concrete Monument
"SM" = Survey Marker Spike/Tag
"PK" = PK/MAG Nail Brand Style