

File **2010-00022580**

PH.# (319) 833-3008
FAX.# (319) 833-3139

SLSI 9-94
BHCO 03-09

Land Survey Monuments situated in Section 36 , Township 89 N ,
Range 12 W , of the Fifth Principal Meridian, BLACK HAWK County, Iowa.
Previously recorded in Misc. Book N/A , Page N/A , in County Recorder's Office.

(Show reason for preparing this certificate): There is No Certificate for the corner on file with County Recorder, per Ia. Code 355.11(1)(a).

(Evidence and detailed procedures used in establishing the corner position(s) and monumentation found or placed.)

Monument Description and Remarks: S.W. 1/16TH COR.

CORNER SET AS PART OF "PLAT OF SURVEY" IN E. 1/2 OF THE S.W.1/4 OF SAID SECTION 36. CORNER OF RECORD PER "AUDITOR KOOPS' PLAT NO. 3", Dtd. NOV. 1948 BEING "SET IRON STAKE". RECORD CORNER NOT FOUND PER HISTORIC QUARRY OPERATIONS AT SITE. CORNER ESTABLISHED w/ RESPECT TO HIST. RECORD, IN ADDITION TO PLAT OF SURVEY DIVISION PER MISC. 170 p.189 (JAN. 1967, PLS 3362). SET #5 RBR. w/ 2" ALUM. CAP. STAMPED "B.H. CO. LAND CORNER" w/ CAP TIPPED W.-S.W.ly. WITHIN N.E. SIDE OF SMALL OVERBURDEN (AGG.) PILE (±4' HT.) IN FRACTURED AGG., AND SURROUNDED WITH LOCAL AGGREGATE FRAGMENTS.

NOTE: ALL DISTANCES PLUMB/HORIZ.
(H.D.), "UNLESS DENOTED".


"NOT TO SCALE"

BHco Hist. Ties: - NONE -

FIELD BOOK: BHco #489 p.10

(Show a minimum of three reference ties to durable physical objects, relevant monuments and physical conditions that will enable recovery of the corner.)

- 1.) TIES PER EDM MEAS. IN "NP" MODE,
AND UTILIZED MLM (INDIRECT) MEAS.

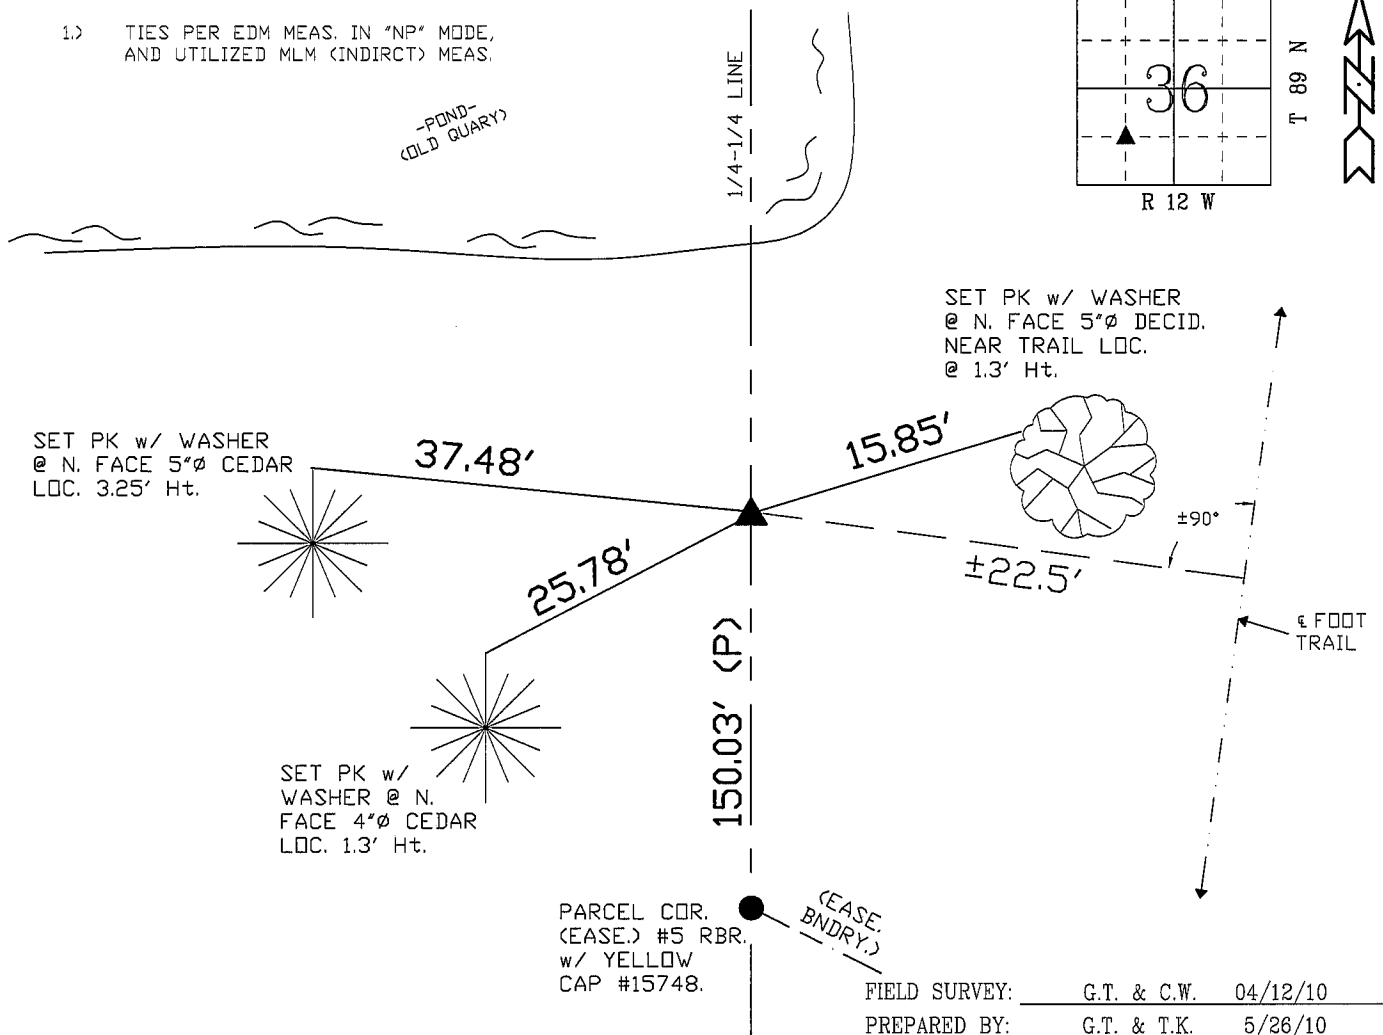

I hereby certify that this land surveying document was prepared and the related survey work was performed by me or under my direct personal supervision and that I am a duly licensed Land Surveyor under the laws of the State of Iowa.


Geoffrey Allen Tinker (date) 06/02/2010

License Number 15748

My license renewal date is December 31, 2010

Pages or sheets covered by this seal:

This Land Corner Certificate Only.

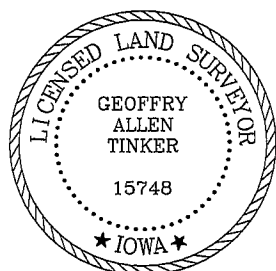

<u>Corner</u>	<u>Section</u> -	<u>Township</u> -	<u>Range</u>
N.E. Cor. SW1/4-SW1/4	36	89 N	12 W

INDEX OF ABBREVIATIONS

(M) = "Measured" Dimension "NP" = Reflectorless EDM Meas.
(P) = "Platted" Dimension "MLM" = Indirect Measure
(R) = "Record" Dimension "CM" = Concrete Monument
(C) = "Calculated" Dimension "SM" = Survey Marker Spike/Tag
"ICS" = Iowa Geodetic Survey "PK" = PK/MAC Nail Brand Style
"WPA" = Works Progress Admin. Survey
"P" = per George Miller Survey (BHC Surveyor 1858-1860)
"B" = per John Ball Survey (BHC Surveyor 1866-1891)
"N" = per Nathan Barber Survey (BHC Surveyor 1908-1931)