

SC
MISC
INDEX *Pe*
MARGIN
PROOF
COMPARE

BLACK HAWK COUNTY IOWA:SS **2172**
FILED FOR RECORD JULY 27, 1999 AT
4:00 P. M. AND RECORDED IN BOOK 335
OF MISC PAGE 196.
Catrina S. Less RECORDER
FEE 1-5.00/
WAYNE CLAASSEN ENGINEERING & SURVEYING

WAYNE CLAASSEN ENGINEERING AND SURVEYING, INC.
P.O. BOX 898 WATERLOO, IOWA 50704-0898

PHONE: (VOICE) 319-235-6294
(FAX) 319-235-0028

UNITED STATES PUBLIC LAND SURVEY CORNER CERTIFICATE


Land Survey Monuments situated in Section 2, Township 89N, Range 13W, of the Fifth Principal Meridian, _____ County, Iowa.
Previously recorded in N/A in County Recorder's Office.
(book, page, document number, etc.)

(Show reason for preparing this certificate, the evidence and detailed procedures used in establishing the corner positions and monumentation found or placed.)

Monument Description and Remarks N¹/₄ Cor. found 3/4" ϕ rebar 9" deep in oiled surface roadway. This is same point as found by CES in Nov. 1970.

PLAN - VIEW

(Show a minimum of three reference ties to durable physical objects, relevant monuments and physical conditions that will enable recovery of the corner.)

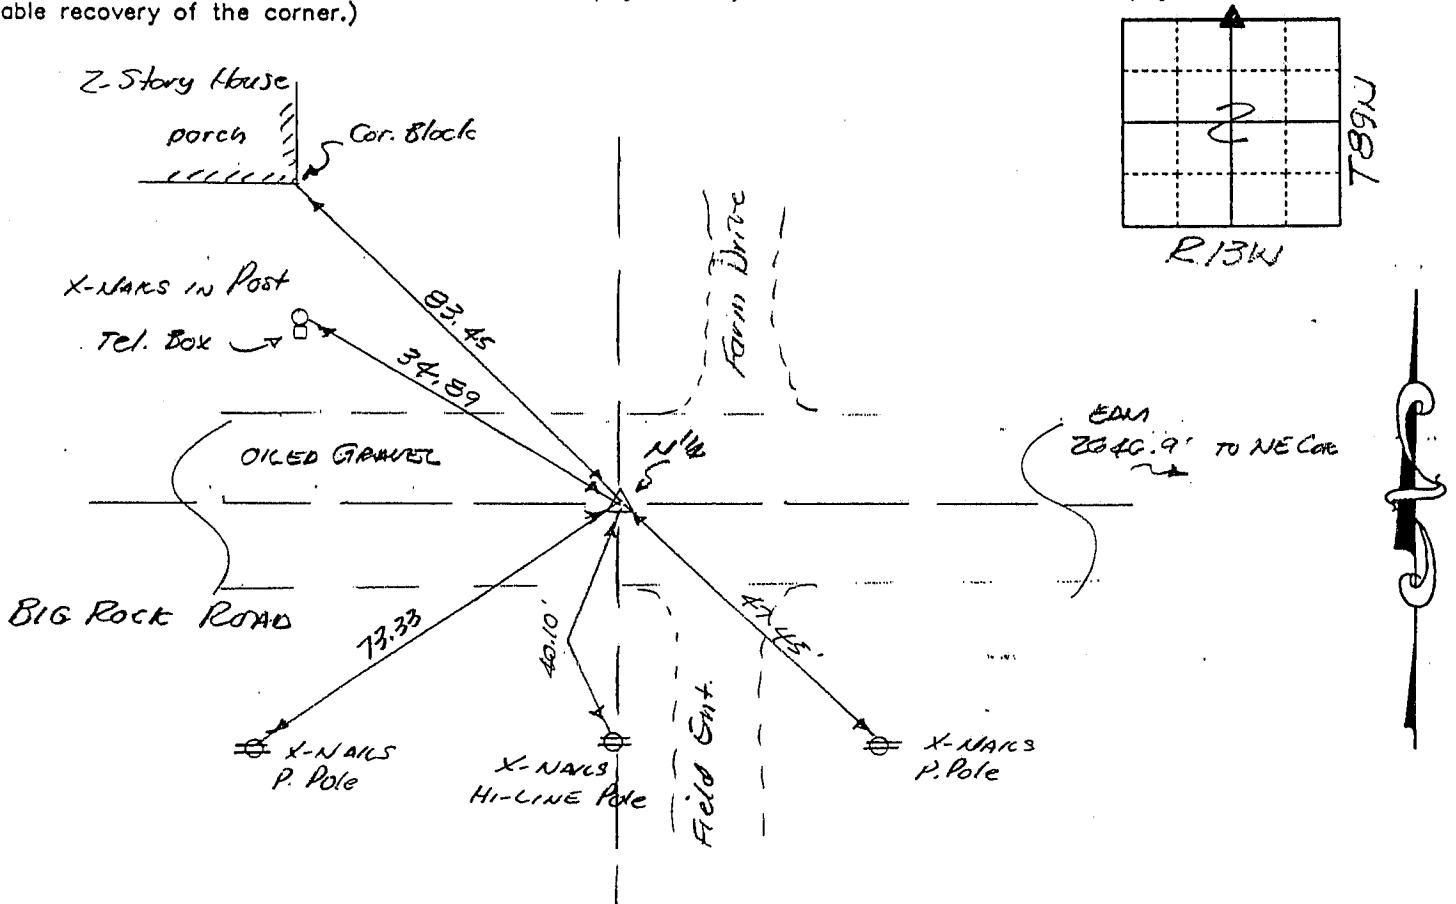


529-6

I hereby certify that the survey work was completed and this certificate was prepared by me or under my direct personal supervision and that I am a duly licensed land surveyor under the laws of the state of Iowa.

Signature: *F. William King*
(Name typed or printed:) F. William King
Date: July 27, 1999 Lic. No. 8033

List Corners to be Indexed

Corners	Section	Twp	Range
<u>N¹/₄</u>	<u>2</u>	<u>89</u>	<u>13</u>

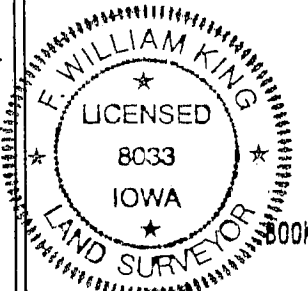

BOOK 335 PAGE 196

SEAL