

MSC  
INDEX  
MARGIN  
PROOF  
COMPARE

BLACK HAWK COUNTY IOWA:SS  
Filed for record Jun 24, 19 98 at 27116  
2:00 P .M. and recorded in Book 330  
of MISC Page 588  
*Wayne Claassen* Recorder  
FEE 1-5.00/  
WAYNE CLAASSEN ENGINEERING AND SURVEYING INC

WAYNE CLAASSEN ENGINEERING AND SURVEYING, INC.  
P.O. BOX 898 WATERLOO, IOWA 50704-0898  
PHONE: (VOICE) 319-235-6294  
(FAX) 319-235-0028

UNITED STATES PUBLIC LAND SURVEY CORNER CERTIFICATE


Land Survey Monuments situated in Section 2, Township 89N, Range 13W, of the Fifth Principal Meridian, BLACK HAWK County, Iowa.  
Previously recorded in N/A in County Recorder's Office.  
(book, page, document number, etc.)

(Show reason for preparing this certificate, the evidence and detailed procedures used in establishing the corner positions and monumentation found or placed.)

Monument Description and Remarks SW CORNER - FOUND 5/8" Ø REBAR IN CONC  
PAVING AS RESET BY CITY AFTER 1997 PAVING PROJECT. THIS CORNER WAS  
PREVIOUSLY USED BY CLAASSEN ENGINEERING FOR PLATTING OF AIRLINE-BURTON  
INDUSTRIAL PARK AND BURTON AVE INDUSTRIAL PARK.

PLAN - VIEW


(Show a minimum of three reference ties to durable physical objects, relevant monuments and physical conditions that will enable recovery of the corner.)

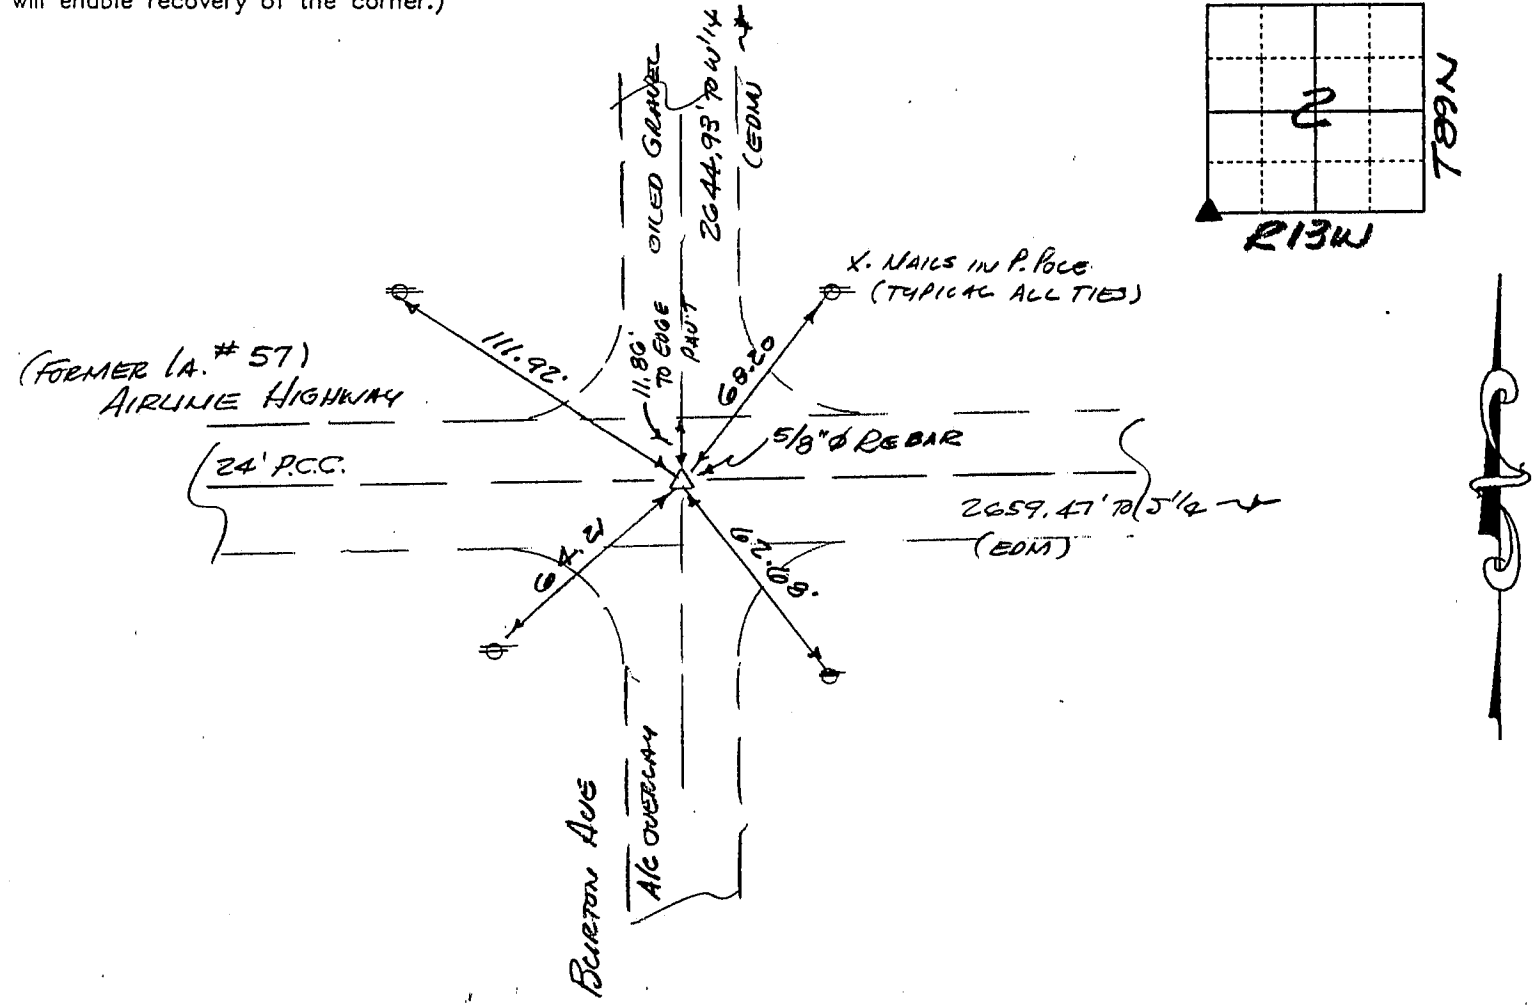

416-56

I hereby certify that the survey work was completed and this certificate was prepared by me or under my direct personal supervision and that I am a duly licensed land surveyor under the laws of the state of Iowa.

Signature: *F. William King*  
(Name typed or printed:) F. WILLIAM KING  
Date: 6-24-1998 Lic. No. 8033

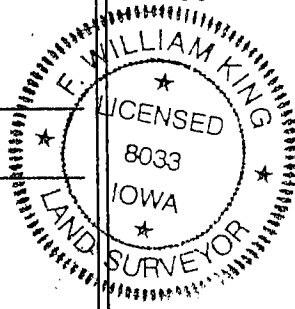

| List Corners to be Indexed |         |     |       |
|----------------------------|---------|-----|-------|
| Corners                    | Section | Twp | Range |
| SW                         | 2       | 89N | 13W   |

SEAL