BLACK HAWK COUNTY IOWA:SS

MARGIN
PROOF
COMPARE


BLACK HAWK COUNTY IOWA:SS
Filed for record Jun 24, 19 98 at
2:00 P .M. and recorded in Book
Of MISC Page 587

1 - 5.00/

WAYNE CLAASSEN ENGINEERING AND SURVEYING INC

WAYNE CLAASSEN ENGINEERING AND SURVEYING, INC. P.O. BOX 898 WATERLOO, IOWA 50704-0898

PHONE: (VOICE) 319-235-6294 (FAX) 319-235-0028 27115

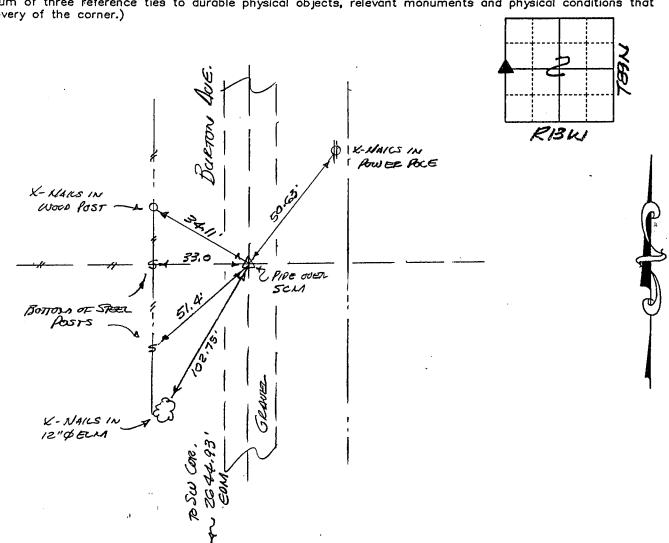

List Corners to be indexed I hereby certify that the survey work was completed and this certificate was prepared by me or under my direct personal supervision and that I am a duly licensed land surveyor under Corners Section Twp Ranae AM KINN W14 Z 3911 13KI the laws of the state of lowa. JAM Ti (Name typed or printed:) F. WILLIAM KINES ENSED Lic. No. 9033 Date: 033 WILLIAM SURVE SEAL INTERNATION OF THE PARTY OF THE BOOK $330_{\text{PAGE}}587$