

SC
MISC
INDEX 11
MARGIN
PROOF
COMPARE

BLACK HAWK COUNTY IOWA:SS 013301

FILED FOR RECORD DEC 17, 1999 AT
1:00 P. M. AND RECORDED IN BOOK 336
OF MISC PAGE 646.

C. J. S. S. RECORDER


FEE 1-5.00/
S & S LAND SURVEYING, INC.
PO BOX 148
WAVERLY, IA 50677

PREPARED BY - S & S LAND SURVEYING, INC., 118 W BREMER AVE., PO BOX 148, WAVERLY, IOWA 50677 - PHONE 319-352-8444


UNITED STATES PUBLIC LAND SURVEY CORNER CERTIFICATE
OF

Land Survey Monuments situated in Section 3, Township 89 NORTH, Range
13 WEST, of the Fifth Principal Meridian, BLACK HAWK County, Iowa.
Previously recorded in Book _____, Page _____.

CORNER WAS LOCATED FOR LAND SURVEY IN THE SOUTHWEST QUARTER, SOUTHEAST
QUARTER, USING TIES FROM THE BLACKHAWK CO. ENGINEERS OFFICE. FOUND 5/8"
REBAR IN P.C.C. PAVING.

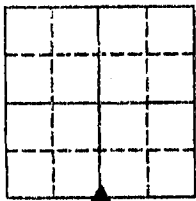

PLAN-VIEW
NO SCALE

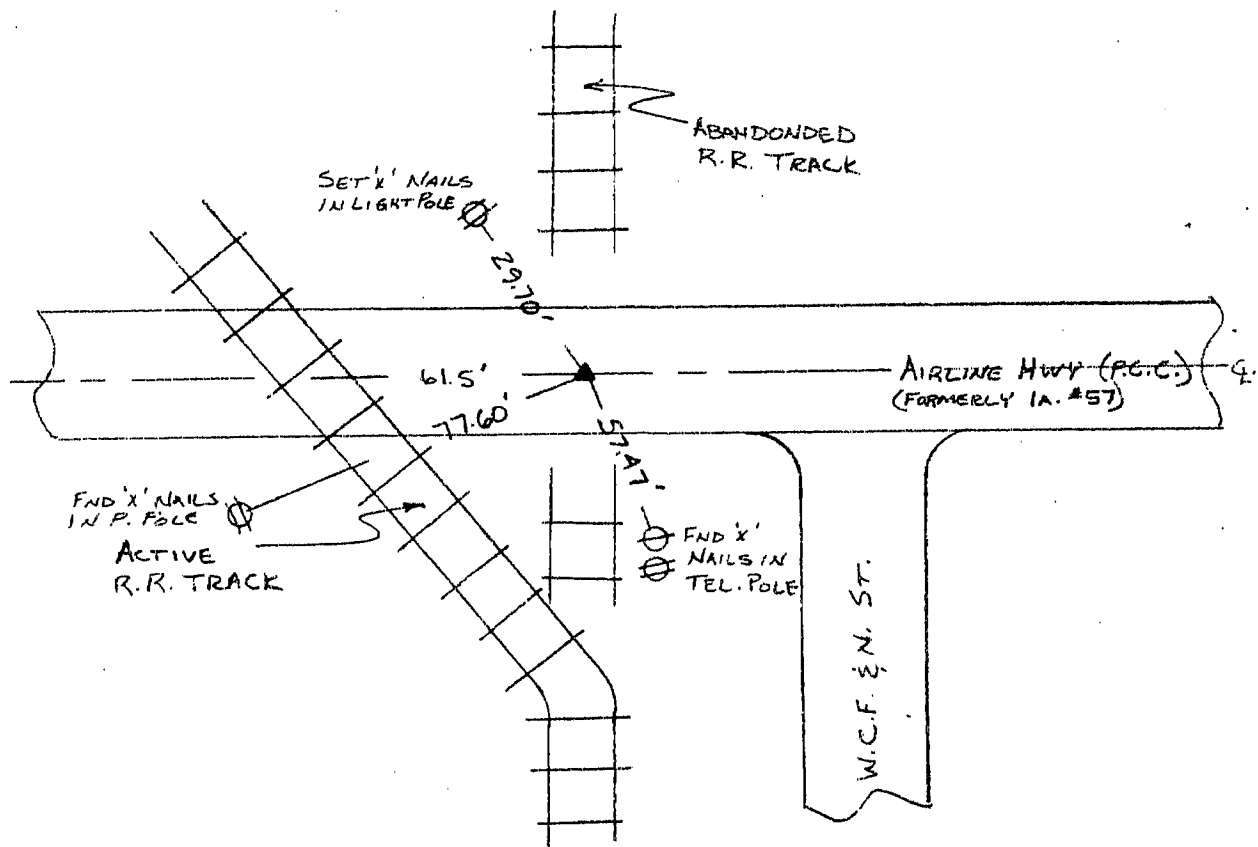


I hereby certify that this land surveying document was prepared
and the related survey work was performed by me or under
my direct personal supervision and that I am a duly Licensed
Professional Land Surveyor under the laws of the State of Iowa.

Scott A. Steinfadt
Scott A. Steinfadt, P.L.S.
Iowa License No. 14677
My License Renewal Date is Dec. 31, 2000.

12/15/99
date

List Corners to be Indexed

Corners 5 1/4 Section 3 Twp 89 Range 13

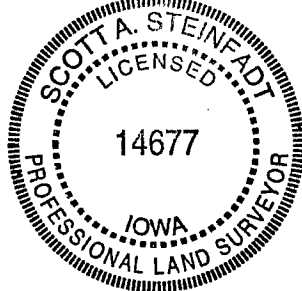

S & S
LAND SURVEYING, INC.

118 W. BREMER AVE. PO BOX 148
WAVERLY, IOWA 50677
(319) 352-8444