

Env
* WAYNE CLAASSEN ENGINEERING AND SURVEYING, INC.
P.O. BOX 898 WATERLOO, IOWA 50704-0898

PHONE: (VOICE) 319-235-6294
(FAX) 319-235-0028

UNITED STATES PUBLIC LAND SURVEY CORNER CERTIFICATE

Land Survey Monuments situated in Section 03, Township 89 North, Range 13 West, of the Fifth Principal Meridian, Black Hawk County, Iowa.

Previously recorded in Misc. 336-646 in County Recorder's Office.
(book, page, document number, etc.)



Monument Description and Remarks

Went to location of S 1/4 Corner and found 'X' cut in concrete instead of 5/8" rebar that reasonably match ties from above Section Corner Certificate.

PLAN - VIEW

- Reason for filing certificate:
- ☐ There is no certificate on file with the Recorder's Office.
 - ☐ Accepts corner position which differs from the one shown in above document.
 - ☒ The corner monument was replaced or modified.
 - ☐ The reference ties in above document were incorrect or missing.

000.00 DENOTES RECORD DIMENSION
FROM CC MISC. BOOK 336-646
(000.00) DENOTES FIELD DIMENSION

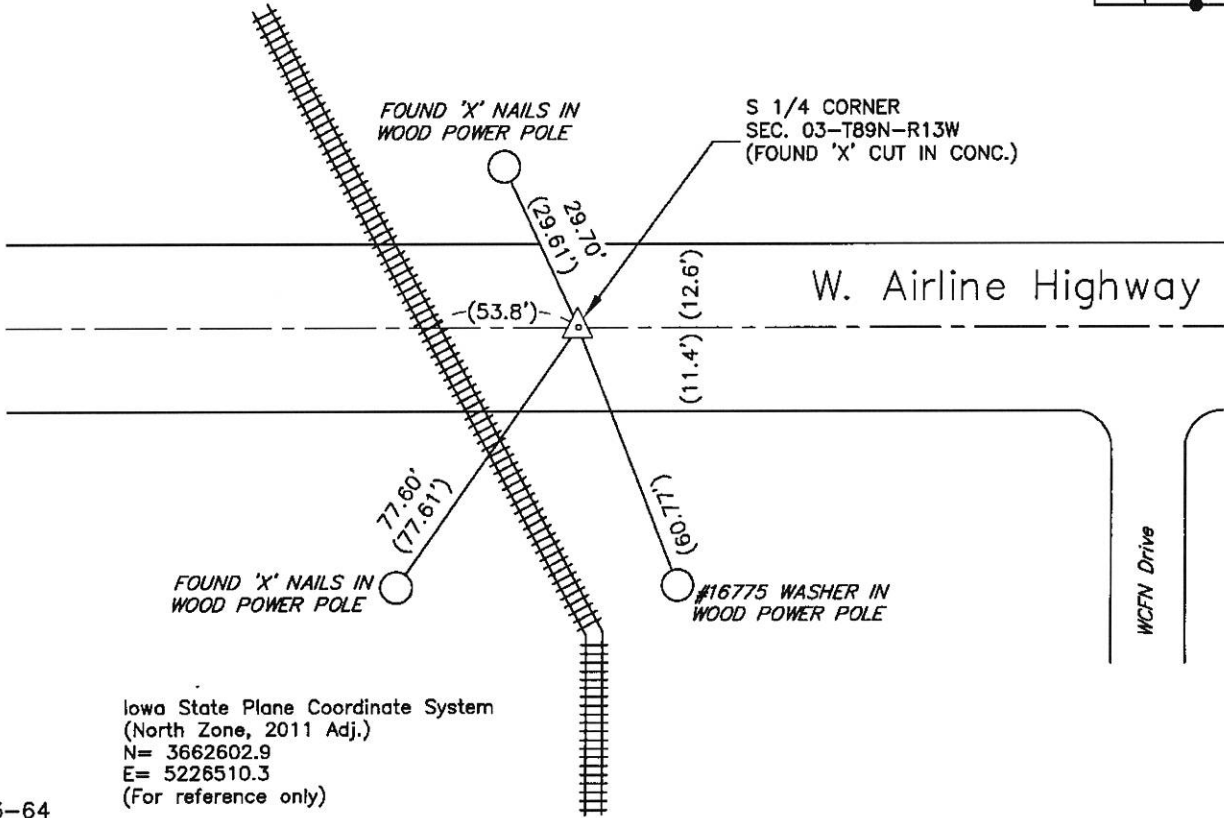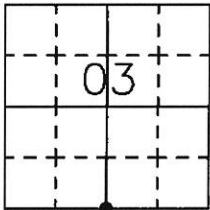

703-64

I hereby certify that this land surveying document was prepared and the related survey work was performed by me or under my direct personal supervision and that I am a duly Licensed Land Surveyor under the laws of the State of Iowa.

Signature: David L. Schell
David L. Schell, L.S.

Date: Jan 22, 2019 Lic. No. 16775

Pages or Sheets Covered by this Seal: THIS SHEET ONLY.

My license renewal date is December 31, 2020

SEAL

List Corners to be Indexed

Corners	Section	Twp	Range
S 1/4 CORNER,	03	89 N	13 W
N 1/4 CORNER,	10	89 N	13 W

