

INDEX &
MARGIN
PROOF
COMPARE

BLACK HAWK COUNTY IOWA:SS
Filed for record OCT 23, 2001 at
4:00 P.M. and recorded in Book _____
at Page _____
Christina S. Lass RECORDER
FEE 1-5.00/
WAYNE CLAASSEN ENGINEERING AND SURVEYING INC

010770

WAYNE CLAASSEN ENGINEERING AND SURVEYING, INC.
P.O. BOX 898 WATERLOO, IOWA 50704-0898

PHONE: (VOICE) 319-235-6294
(FAX) 319-235-0028

UNITED STATES PUBLIC LAND SURVEY CORNER CERTIFICATE


Land Survey Monuments situated in Section 6, Township 89N, Range 13W, of the Fifth Principal Meridian, BLACK HAWK County, Iowa.
Previously recorded in N/A in County Recorder's Office.
(book, page, document number, etc.)

(Show reason for preparing this certificate, the evidence and detailed procedures used in establishing the corner positions and monumentation found or placed.)

Monument Description and Remarks Found 3/4" clip pipe 6" deep under asphalt paving. Dug 1'2" below pavt - found nothing - used prod rod below pin 2' in bottom of hole, 4'4" nothing. Accepted 3/4" clip pipe. CES set clip pipe over 5CM in 1966. E 1/4 Cor. G-89-13

PLAN - VIEW

(Show a minimum of three reference ties to durable physical objects, relevant monuments and physical conditions that will enable recovery of the corner.)

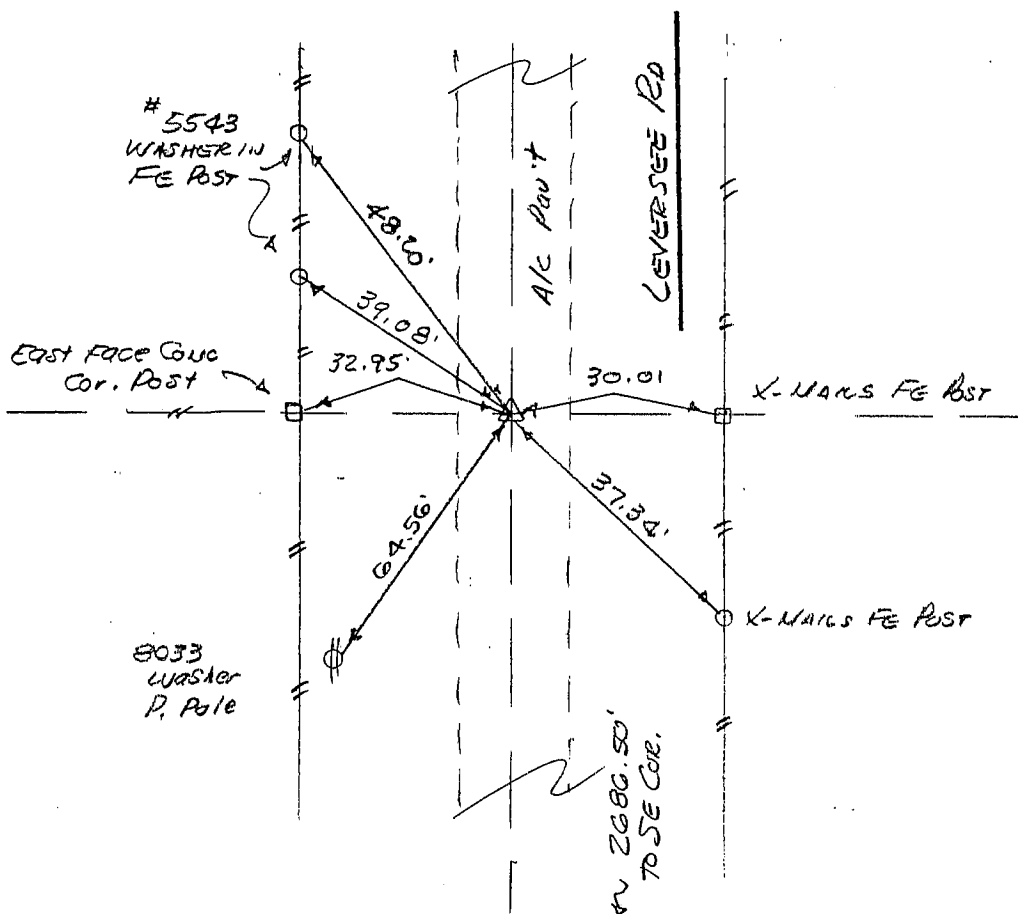

504-9

I hereby certify that the survey work was completed and this certificate was prepared by me or under my direct personal supervision and that I am a duly licensed land surveyor under the laws of the state of Iowa.


Signature: *F. William King*
(Name typed or printed:) F. WILLIAM KING

Date: Oct. 15, 2001 Lic. No. 8033

SEAL

List Corners to be Indexed

Corners	Section	Twp	Range
<u>E 1/4</u>	<u>6</u>	<u>89N</u>	<u>13W</u>

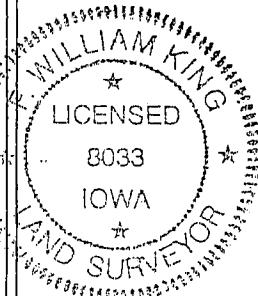

BOOK 0344 PAGE 578