


OF

(Show reason for preparing this certificate, the evidence and detailed procedures used in establishing the corner positions and monument found or placed.)  
Monument Description and Remarks: FOUND CUPA MONUMENT PER WALKS DOT PLANS  
TIES 1979.

(Show a minimum of three reference ties to durable physical objects, relevant monuments and physical conditions that will enable recovery of the corner.)

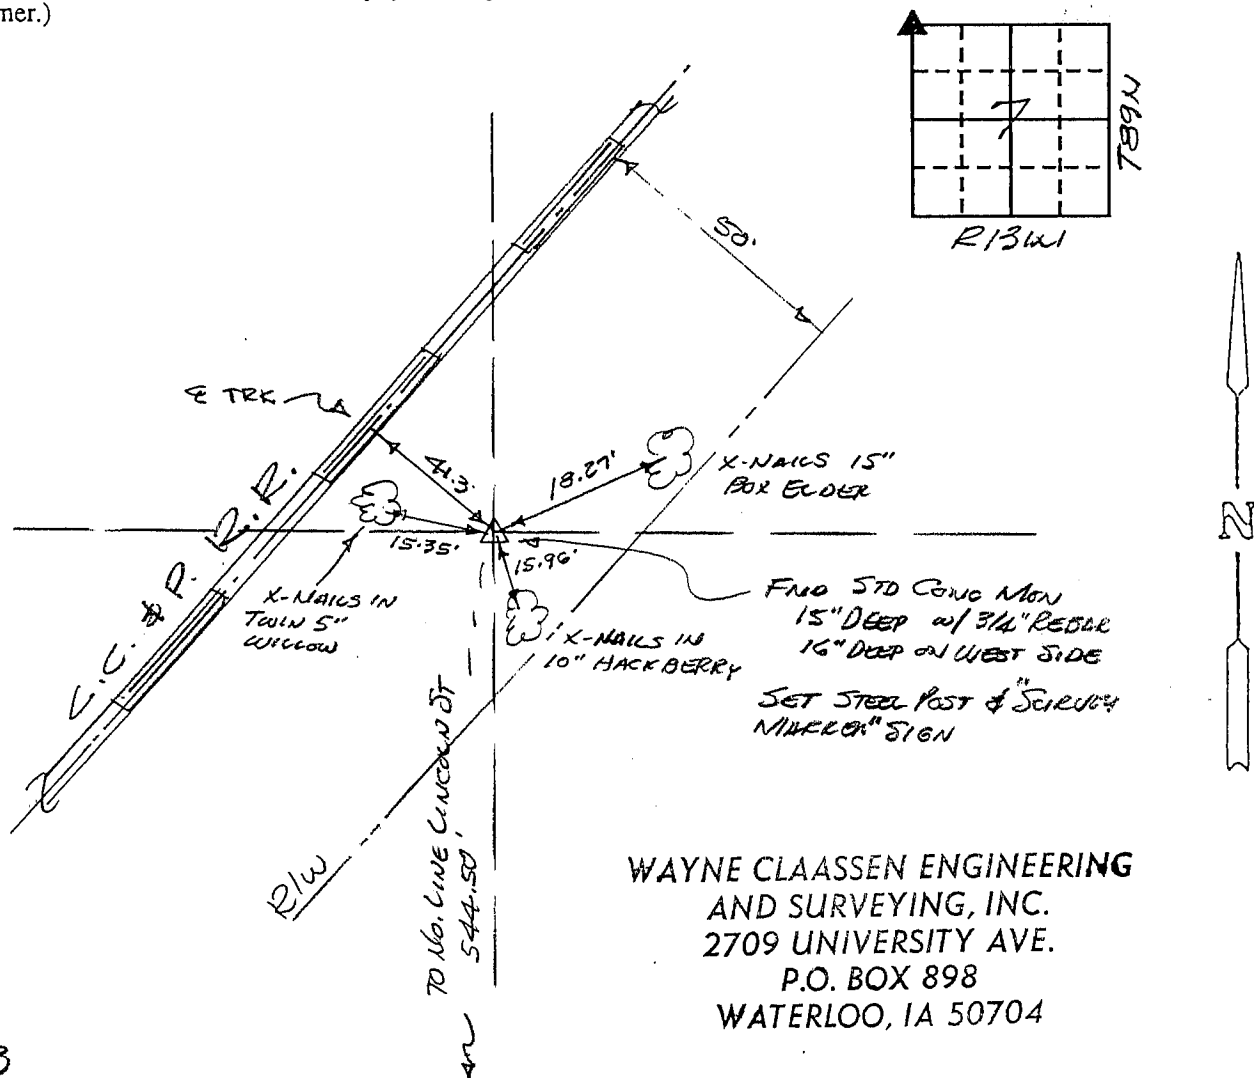

**WAYNE CLAASSEN ENGINEERING  
AND SURVEYING, INC.  
2709 UNIVERSITY AVE.  
P.O. BOX 898  
WATERLOO, IA 50704**

I hereby certify that the survey work was completed and this certificate was prepared by me or under my direct personal supervision and that I am a duly registered land surveyor under the laws of the state of Iowa.

Signature:

Name typed or printed: F. Lee King

Date: 4-18-1994 Reg. No. 1 8033



Corners	List Corners to be Indexed Section	Twp	Range
1100	7	89N	1300

~~12 89 110~~

MISC. BK. 310 p. 674