


BLACK HAWK COUNTY IOWA:SS
Filed for record _____ Oct 29 _____, 19 98 at 10066
4:00 P _____ .M. and recorded in Book _____
of _____ Page _____.
Catrice A. Sess Recorder
FEE 1-5.00/_____
WAYNE CLAASSEN ENGINEERING
PO BOX 898
WATERLOO IA 50704

PHONE: (VOICE) 319-235-6294
(FAX) 319-235-0028

Land Survey Monuments situated in Section 9, Township 89N, Range 13W, of the Fifth Principal Meridian, _____ County, Iowa.
Previously recorded in N/A in County Recorder's Office.
(book, page, document number, etc.)


Monument Description and Remarks NE Cor. Sec. 9-89-13 Found 1/2" Ø rebar in P.C. Conc.
Pav't (City of Waterloo 1998 Project). This corner was marked by a lead plug per
D.O.T. Survey 1970, in concrete base pav't. - D.O.T. set nail in asphalt over lead plug. Wallace &
Holland survey of 1979 found P.K. nail at this location. CES found 20d spike in asphalt
in Dec. 1979.

(Show a minimum of three reference ties to durable physical objects, relevant monuments and physical conditions that will enable recovery of the corner.)

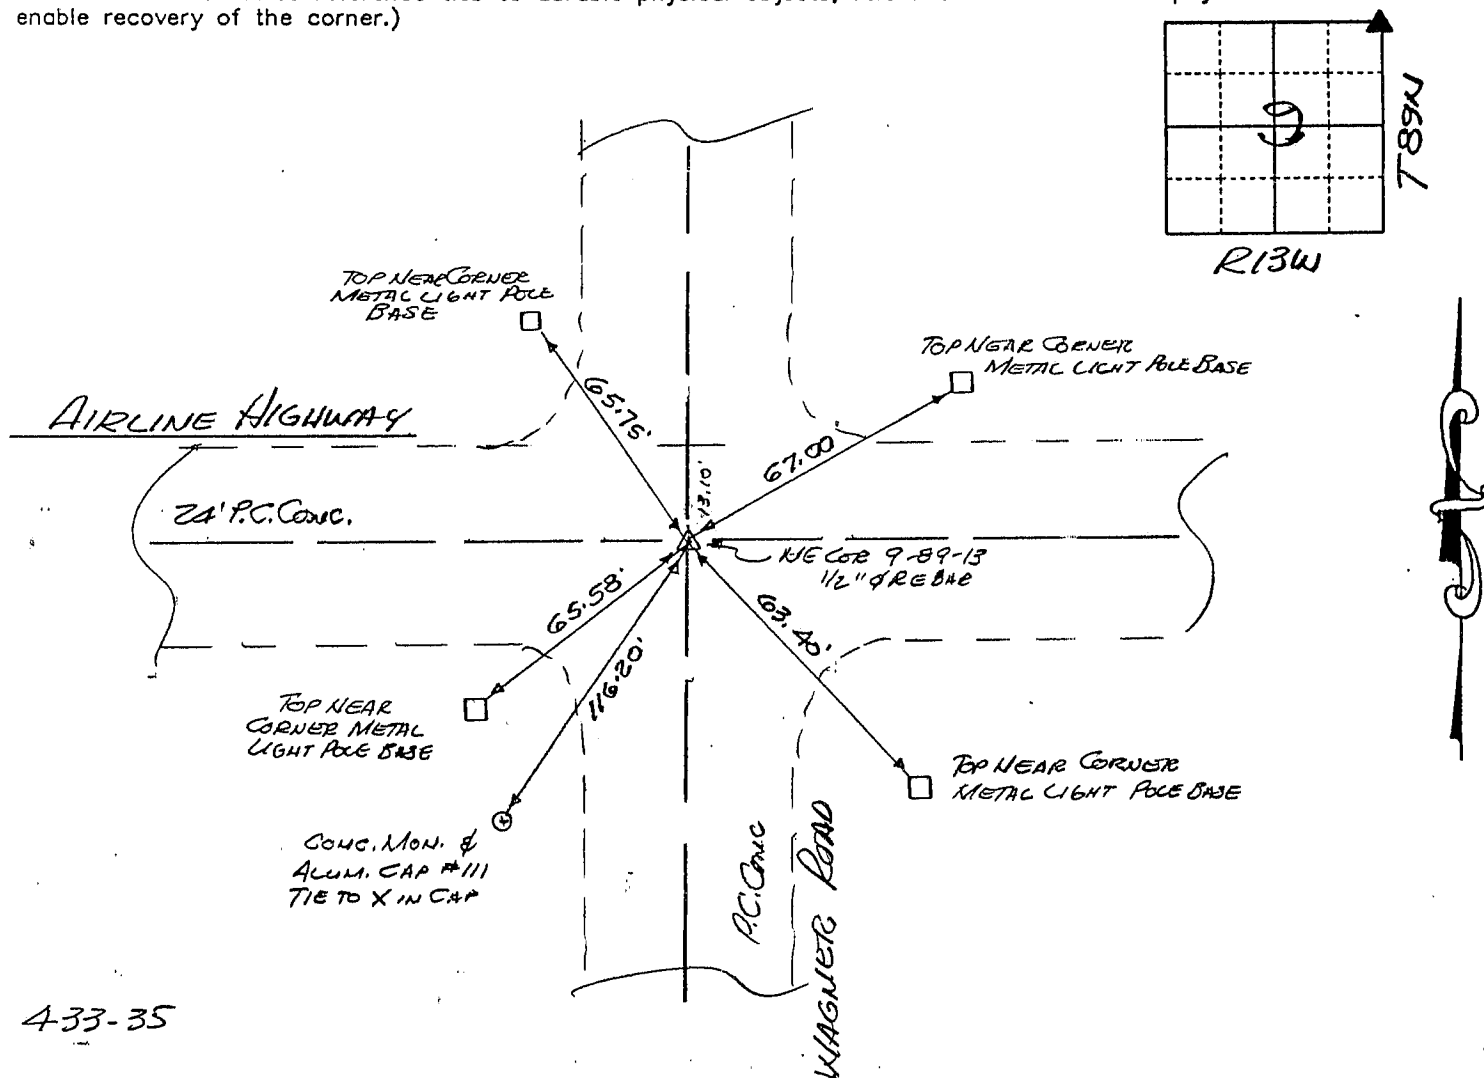

Corners	Section	Twp	Range
NE	9	89N	13W

SEAL

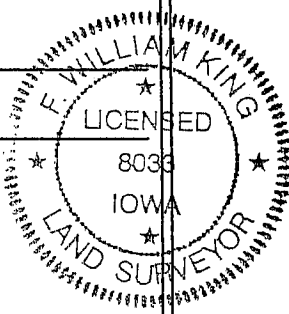

BOOK 332 PAGE 110