

SC  
Misc  
H. HELLAND  
MARGIN  
PROOF  
COMPARE

BLACK HAWK COUNTY IOWA:SS 10895  
FILED FOR RECORD Dec 2 1997 AT  
3:00P M., AND RECORDED IN BOOK 328  
OF Misc PAGE 294  
RECORDER  
FEE 1-5.00X  
PAUL HELLAND

PAUL H. HELLAND, 1107 TECHNOLOGY PARKWAY, CEDAR FALLS, IOWA 50613, (319)-266-0161

# UNITED STATES PUBLIC LAND SURVEY CORNER CERTIFICATE OF

LAND SURVEY MONUMENTS SITUATED IN SECTION NO. 11, TOWNSHIP NO. 89N, RANGE  
NO. 13W, OF THE FIFTH PRINCIPAL MERIDIAN, BLACK HAWK COUNTY, IOWA.  
PREVIOUSLY RECORDED IN BOOK, PAGE.

(SHOW REASON FOR PREPARING THIS CERTIFICATED, THE EVIDENCE AND DETAILED PROCEDURES USED IN ESTABLISHING THE CORNER POSITIONS  
AND MONUMENTATION FOUND OR PLACED.)


## MONUMENT DESCRIPTION AND REMARKS:

SURVEY DONE IN SE 1/4 NE 1/4 SEC. 11-89-13  
N 1/4 CORNER - SET MAG NAIL IN A.C.C. PAVEMENT FROM CONCRETE TIE MONUMENTS

CENTER - FOUND 1 1/4" DIA. PINCHED PIPE NORTH OF T-POST, 0.3' DEEP W/PINK FLAGGING

## PLAN VIEW


(SHOW A MINIMUM OF THREE REFERENCE TIES TO DURABLE PHYSICAL OBJECTS, RELEVANT MONUMENTS AND PHYSICAL CONDITIONS THAT WILL  
ENABLE RECOVERY OF THE CORNER.)

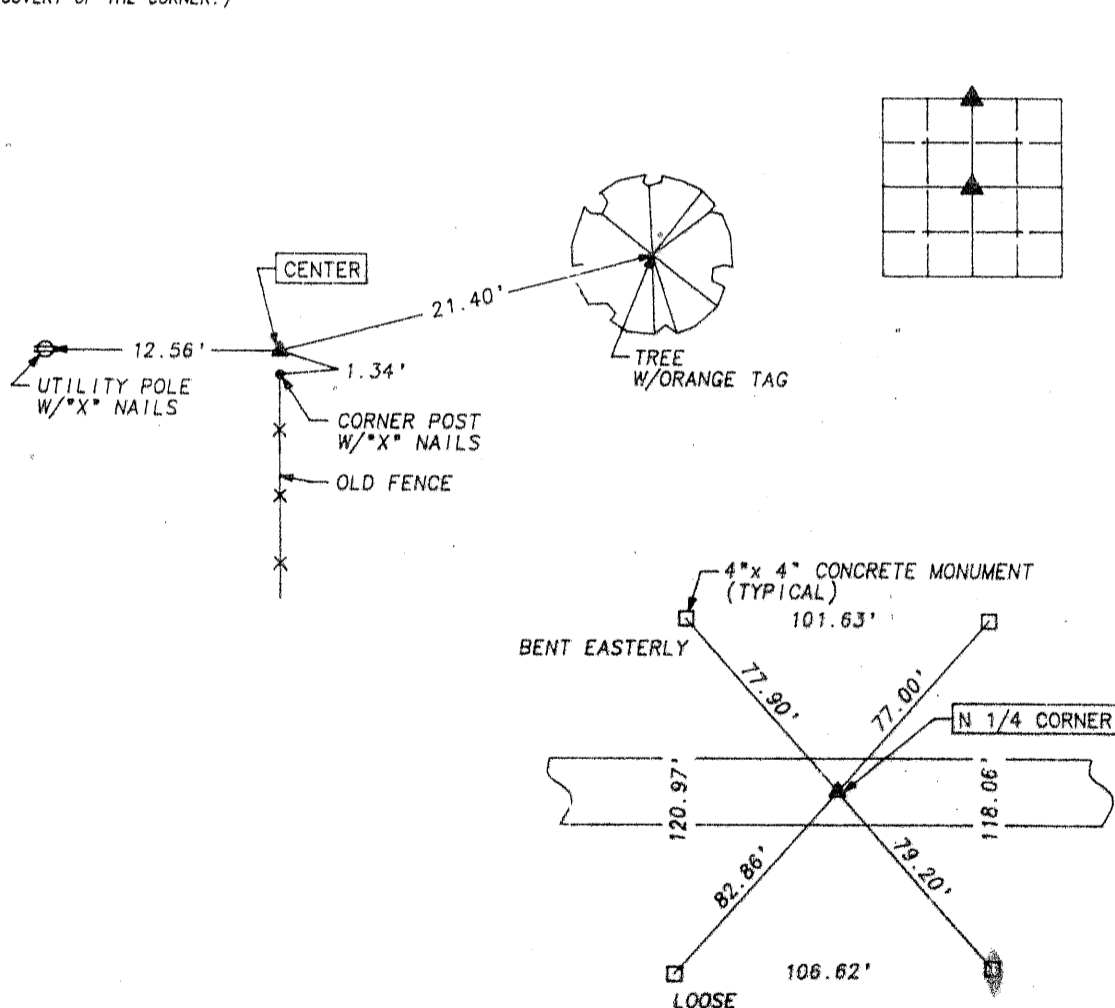

I HEREBY CERTIFY THAT THIS PLAT, MAP, SURVEY OR REPORT WAS MADE  
BY ME OR UNDER MY DIRECT PERSONAL SUPERVISION AND THAT I AM A  
DULY REGISTERED LAND SURVEYOR UNDER THE LAWS OF THE STATE OF IOWA

DATE 12/2/97  
PAUL H. HELLAND, P.E. & R.L.S. IOWA REGISTRATION NO. 6505  
MY REGISTRATION EXPIRES DECEMBER 31, 1997

HELLAND ENGINEERING  
& SURVEYING, LTD.  
1107 TECHNOLOGY PARKWAY  
CEDAR FALLS, IOWA 50613  
319-266-0161

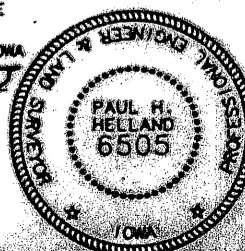

## LIST CORNERS TO BE INDEXED

CORNER	SECTION	TOWNSHIP	RANGE
N 1/4	11	89N	13W
CENTER	11	89N	13W