

UNITED STATES PUBLIC LAND SURVEY CORNER CERTIFICATE

OF

Land Survey Monuments situated in Section 11, Township 89 N, Range 13 W, of the Fifth Principal Meridian, BLACK HAWK County, Iowa.
 Previously recorded in _____ in County Recorder's Office.
 (book, page, document number, etc.)


(Show reason for preparing this certificate, the evidence and detailed procedures used in establishing the corner positions and monumentation found or placed.)

Monument Description and Remarks: FOUND ALUM DOT CAP

MONUMENT

PLAN - VIEW

(Show a minimum of three reference ties to durable physical objects, relevant monuments and physical conditions that will enable recovery of the corner.)

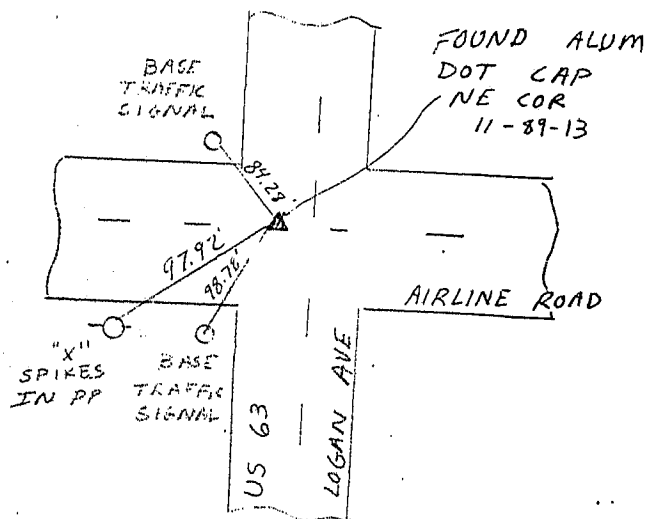

I hereby certify that the survey work was completed and this land surveying document was prepared by me or under my direct personal supervision and that I am a duly registered land surveyor under the laws of the state of Iowa


Signature: Myron Scheibo

Name typed or printed: Myron Scheibo

Date: 10-15-96 Reg. No. 8807

My registration renewal date is December 31, 1999

SEAL

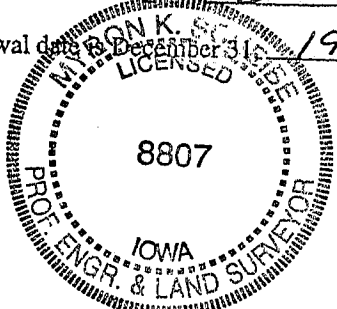

Corners	List Corners to be Indexed	Section	Twp	Range
NE COR	11	89 N	13 W	