

Number: 202200021533
Recorded: 5/9/2022 at 11:17:09.0 AM
County Recording Fee: \$7.00
Iowa E-Filing Fee: \$3.00
Combined Fee: \$10.00
Revenue Tax:
Sandie L. Smith, RECORDER
Black Hawk County, Iowa

Prepared by & Return to: Herold - Reicks Surveying, 2206 East Bremer Avenue, Waverly, IA 50677, Ph. 319-483-5187

United States Public Land Survey Corner Certificate

Land Survey Monument situated in
Section 11, Township 89 North, Range 13 West of the Fifth Principal Meridian, Black Hawk County, Iowa.
Not on file in the County Recorder's Office.

This certificate is being prepared in compliance
with Iowa Code Chapter 355.11 because:


- ☒ There is no certificate on file for this corner.
☐ There are no longer three valid ties of record.
☐ There are changes to reference ties of record.
☐ There is change of monumentation of record.
☐ To clarify description of record monument (ties).

Monument Description and Remarks:

Southwest Corner: Found Tack Nail with information obtained from Cornerstone Ties Field Book 1, T89N R13W, Page 40, on file in the County Engineer's Office. Accepted the monument as the corner after comparing the position to adjacent corners in said Section.

Plan View

(Show a minimum of three reference ties to durable physical objects, relevant monuments and physical conditions that will enable recovery of the corner.)

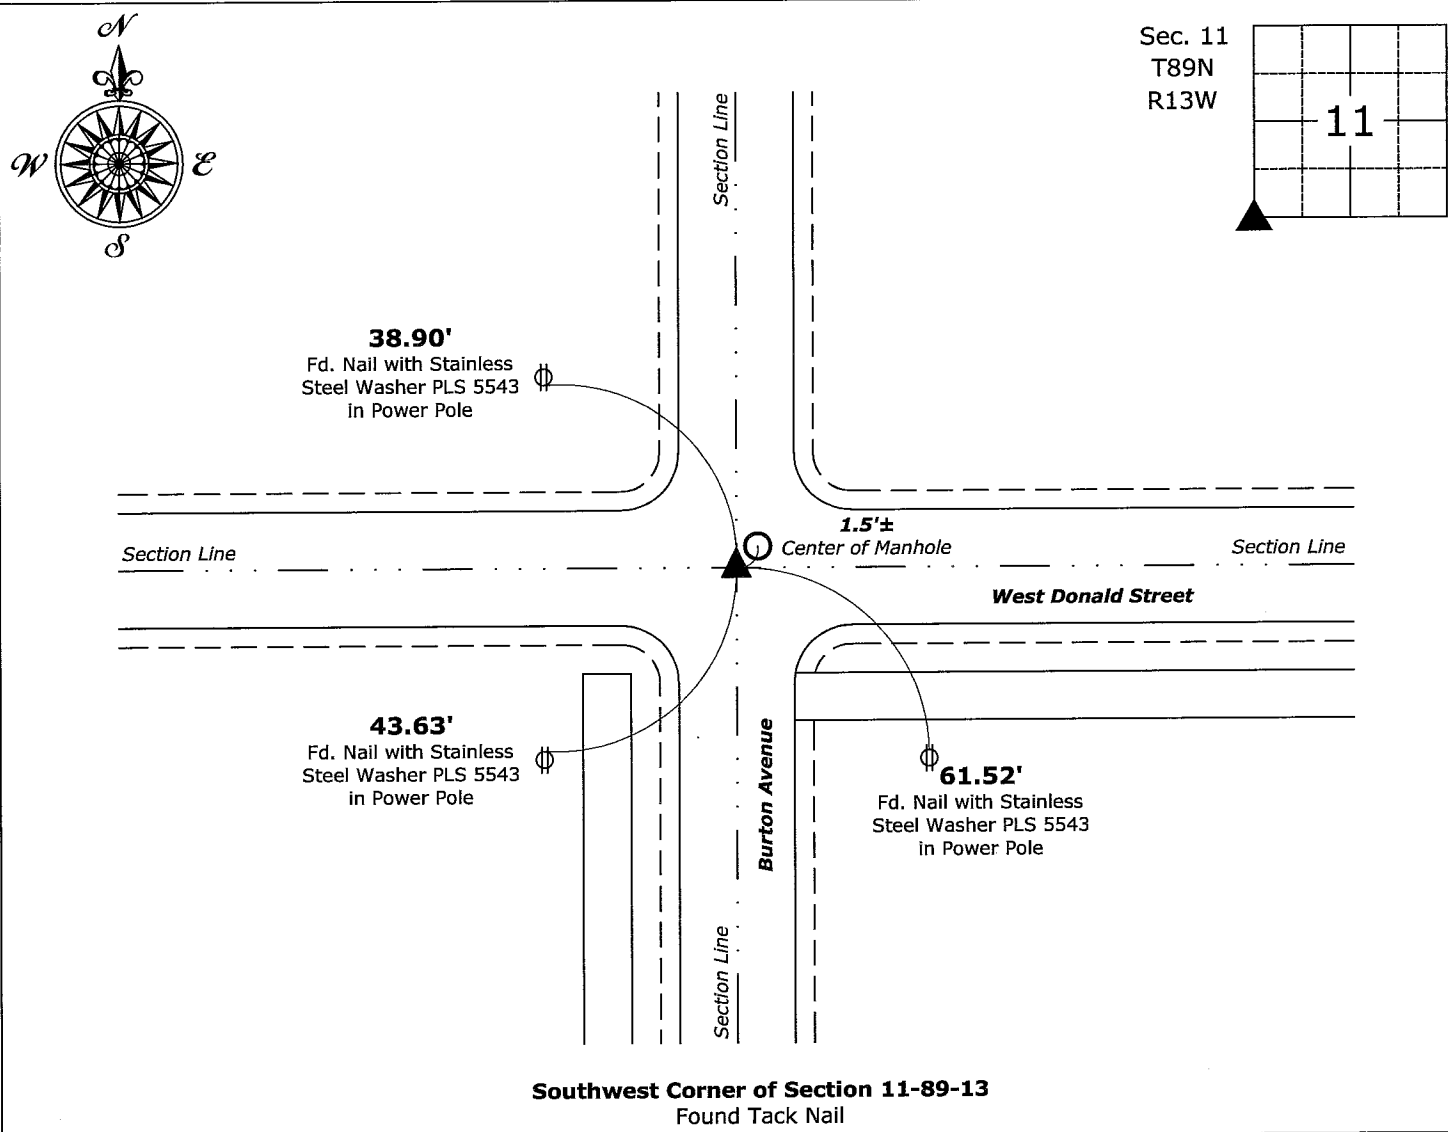

Southwest Corner of Section 11-89-13
Found Tack Nail



I hereby certify that this land surveying document was prepared and the related survey work was performed by me or under my direct personal supervision and that I am a duly licensed Land Surveyor under the laws of the State of Iowa.
Isaiah M. Reicks
Isaiah M. Reicks Date: 5-4-22
License number 22468
My license renewal date is December 31, 2023.
Sheets covered by this seal: Individual sheet only

| List Corner to be Indexed | | | |
|------------------------------|---------|------|-------|
| Corner | Section | Twp. | Range |
| SW | 11 | 89 | 13 |
| Project Number: 2022-519 | | | |
| FB: Black Hawk 1, Pgs. 36-37 | | | |