

AMENT INC
5825 DRY CREEK LN
CEDAR RAPIDS, IA 52402

I *sw*
P
Z

Document Number: 2008016029
Date: Feb 15, 2008 4:30:00 pm
Aud Fee: 0.00 Rec Fee: 5.00
Trans Tax: 0.00 Rec Management Fee: 1.00
E-Com Fee: 1.00 Non-Standard Page Fee: 0.00
Filed for record in Black Hawk County, Iowa
Judith A. McCarthy, County Recorder


PREPARED BY: GREGG E. SAMPSON, AMENT, INC., 5825 DRY CREEK LANE NE, CEDAR RAPIDS, IA 52402 (319) 378-1401

UNITED STATES PUBLIC LAND SURVEY CORNER CERTIFICATE
OF

Land Survey Monuments situated in Section 12 Township 89 Range
13 WEST of the Fifth Principal Meridian BLACK HAWK County, Iowa.
Previously recorded in N/A in the County Recorder's Office.

Monument Description and Remarks: FOUND 1" DIAMETER PINCH PIPE 8" BELOW GROUND
AS SHOWN ON "AMENDED PLAT OF SURVEY" RECORDED AT THE BLACK HAWK COUNTY
RECORDER'S OFFICE IN BOOK 0074, PAGE 475. ALL TIE POINTS ARE 1/2" X 30"
REBAR SET FLUSH.

PLAN - VIEW

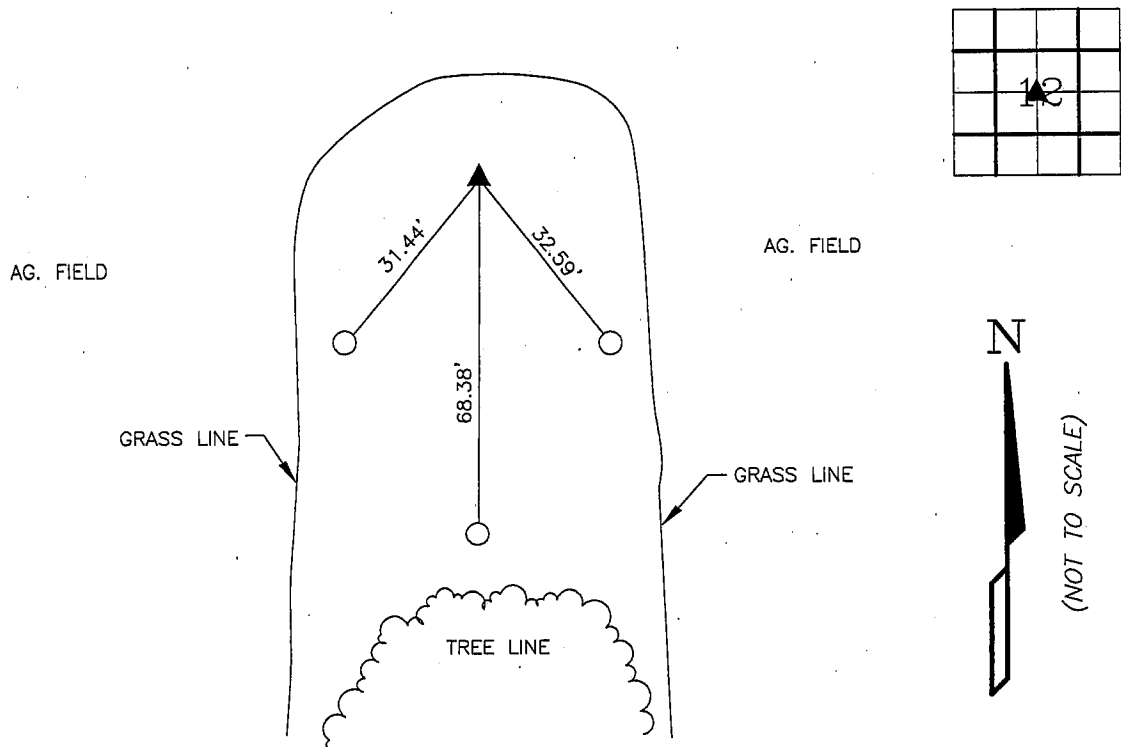

I hereby certify that the survey work was completed and this certificate was prepared by me or under my direct personal supervision and that I am a duly licensed land surveyor under the laws of the state of Iowa.

Signature: *Gregg E. Sampson*
Gregg E. Sampson, Iowa Licensed Land Surveyor No. 14809

Date: 2-15-08 License renewal December 31, 2008

SEAL



List Corners to be Indexed
Corners Section Twp Range
CENTER 12 89N. 13W.