

ENV
*WAYNE CLAASSEN ENGINEERING AND SURVEYING, INC.
P.O. BOX 898 WATERLOO, IOWA 50704-0898

PHONE: (VOICE) 319-235-6294
(FAX) 319-235-0028

UNITED STATES PUBLIC LAND SURVEY CORNER CERTIFICATE

Land Survey Monuments situated in Section 12, Township 89 North, Range 13 West, of the Fifth Principal Meridian, Black Hawk County, Iowa.
Previously recorded in Misc. Book 296, Page 443 in County Recorder's Office.
(book, page, document number, etc.)



Monument Description and Remarks

Went to location of corner and it was missing. Set mag nail and washer #16775 using ties from above corner certificate.

PLAN - VIEW

- Reason for filing certificate:
☐ There is no certificate on file with the Recorder's Office.
☐ Accepts corner position which differs from the one shown in above document.
☒ The corner monument was replaced or modified.
☐ The reference ties in above document were incorrect or missing.

000.00 DENOTES RECORD DIMENSION FROM CERTIFICATE
MISC. BOOK 296-443
(000.00) DENOTES FIELD DIMENSION

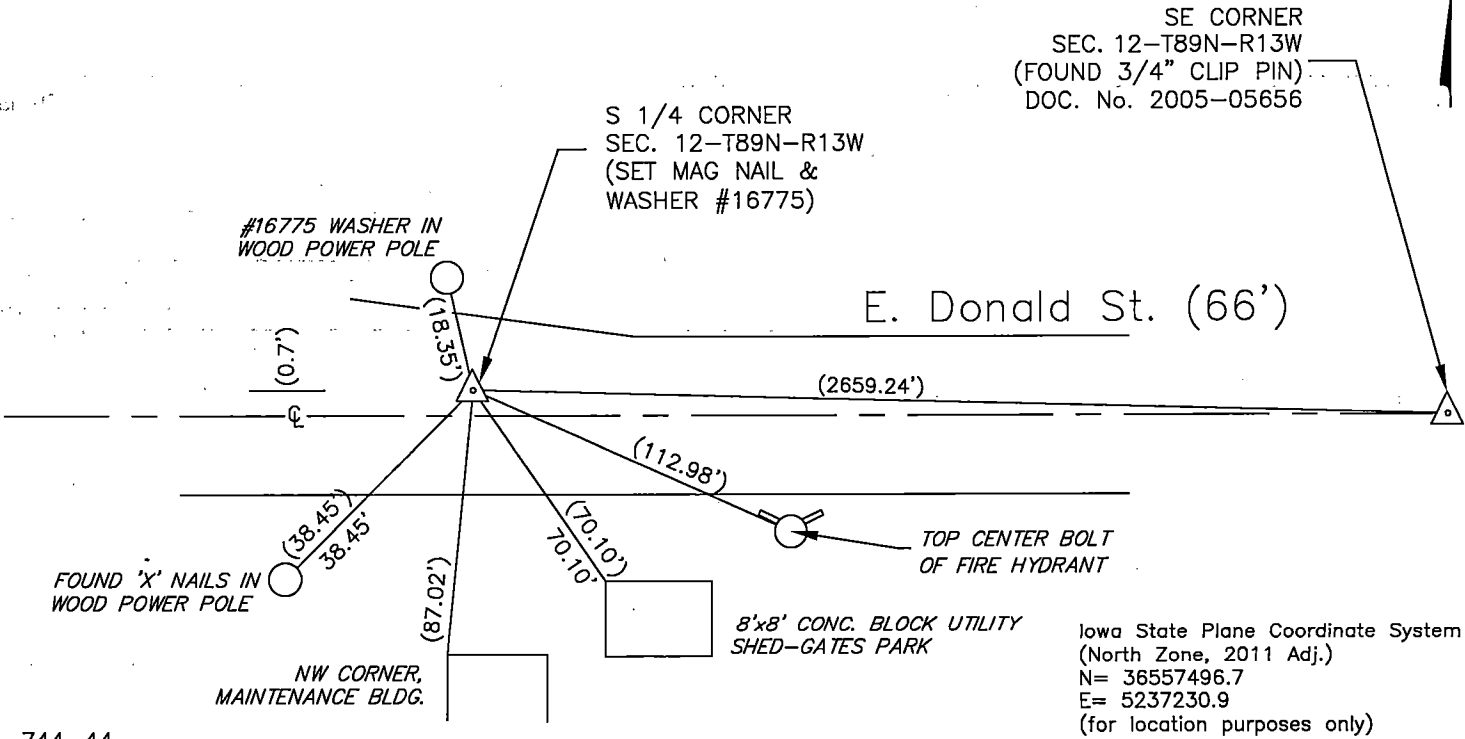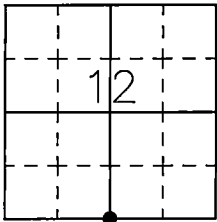

Iowa State Plane Coordinate System
(North Zone, 2011 Adj.)
N= 36557496.7
E= 5237230.9
(for location purposes only)

I hereby certify that this land surveying document was prepared and the related survey work was performed by me or under my direct personal supervision and that I am a duly Licensed Land Surveyor under the laws of the State of Iowa.

Signature: [Signature]
David L. Scheil, L.S.
Date: SEPT. 28, 2020 Lic. No. 16775
Pages or Sheets Covered by this Seal: THIS SHEET ONLY.
My license renewal date is December 31, 2020
SEAL

List Corners to be Indexed			
Corners	Section	Twp	Range
S 1/4 CORNER,	12	89 N	13 W
N 1/4 CORNER,	13	89 N	13 W

