

File **2020-00020855**

UNITED STATES PUBLIC LAND SURVEY CORNER CERTIFICATE
OF

Land Survey Monuments situated in Section 12, Township 89N, Range 13W
of the Fifth Principal Meridian, BLACK HAWK County, Iowa.

Previously recorded in BOOK 333 OF MISC. PG 26 &
BOOK 296 OF MISC. PG 440 in County Recorder's Office.
(book, page, document number, etc.)

(Show reason for preparing this certificate, the evidence and detailed procedures used in establishing the corner positions and monumentation found or placed.)

Monument Description and Remarks: NW CORNER: REPLACED PREVIOUSLY FOUND IDOT ALUMINUM DISC
WITH MAG SPIKE/IDOT SEC. COR. WASHER *22293 3.5'± EAST OF C OF SOUTH BOUND LANE OF US 63 PER
PREVIOUS CERT OF RECORD FILE BOOK 333 OF MISC. PAGE 26 AFTER RESURFACING PROJECT
NHSN-063-(93)--2R-07.



REASON FOR MONUMENTATION AND TIES HAVE CHANGED.

W 1/4 CORNER: REPLACED PREVIOUSLY FOUND IDOT ALUMINUM DISC WITH MAG SPIKE/IDOT SEC. COR. WASHER.
*22293 4.0' EAST ϕ OF SOUTH BOUND LANE US 63 PER IDOT INFORMATION OF RECORD MISC. BOOK 296 PAGE
440 AFTER RESURFACING PROJECT NHSN-063-6(93)--2R-07.

REASON FOR CERT: MONUMENTATION AND TIES HAVE CHANGED.

PLAN - VIEW

(Show a minimum of three reference ties to durable physical objects, relevant monuments and physical conditions that will enable recovery of the corner.)

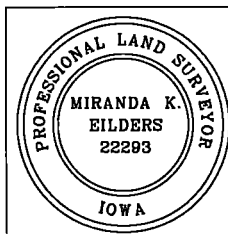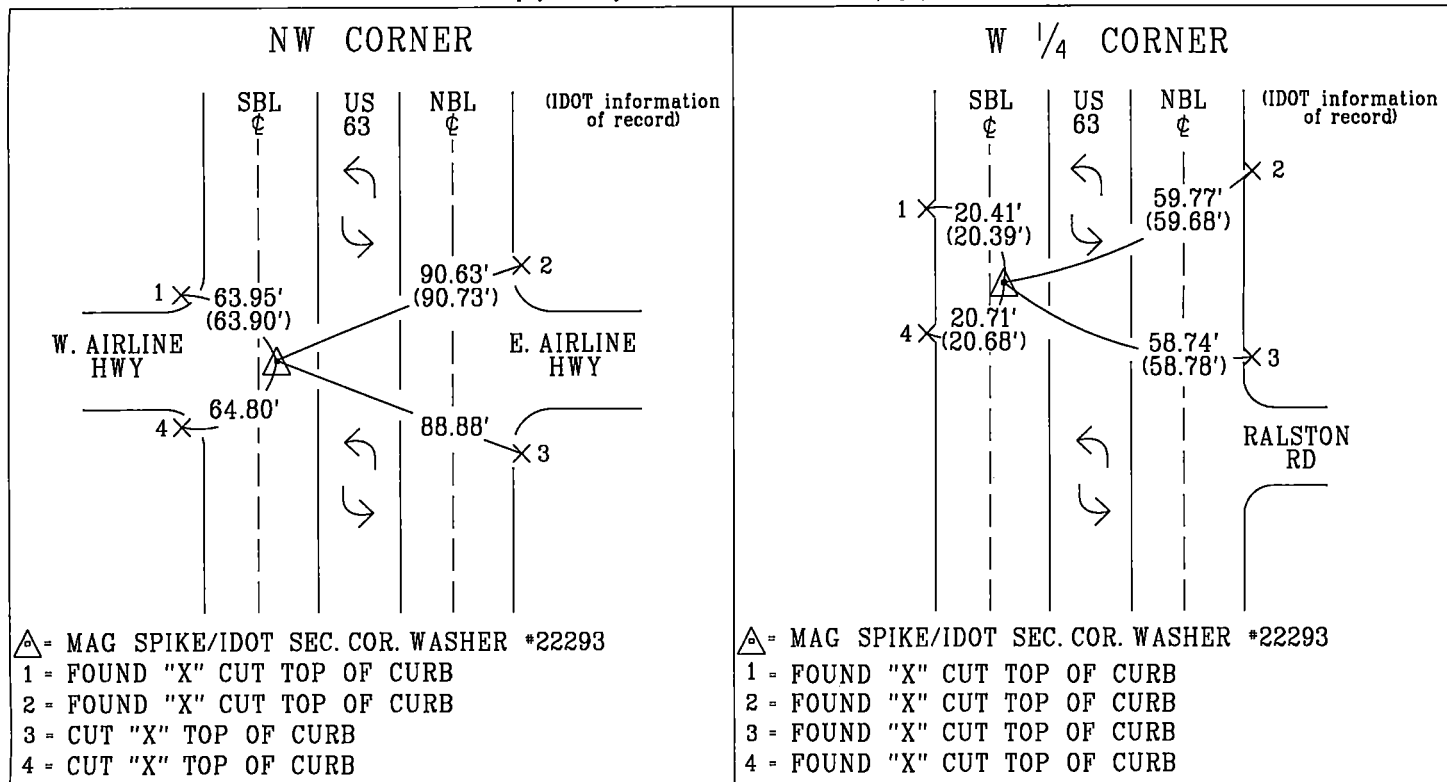

I hereby certify that this land surveying document was prepared and the related survey work was performed by me or under my personal supervision and that I am duly licensed professional Land Surveyor under the laws of the state of Iowa.

My License renewal date is December 31, 2021
 Pages or sheets covered by this seal. 1

List Corners to be Indexed			
Corner	Section	Township	Range

NW CORNER	12	89N	13W
W 1/4 CORNER	12	89N	13W

