

VEENSTRA & KIMM INC 3000 WEST OWN PARKWAY WEST DES MOINES IA 50266 1320

VEENSTRA AND KIMM, INC. 3000 WESTOWN PARKWAY WEST DES MOINES, IOWA 50266-1320 515-225-8000

UNITED STATES PUBLIC LAND SURVEY CORNER CERTIFICATE
OF


Land Survey Monuments situated in Section 13, Township 89 N, Range 13 W, of the
Fifth Principal Meridian, BLACK HAWK County, Iowa.
Previously recorded in N/A (book, page, document number, etc.) in County Recorder's Office.

(Show reason for preparing this certificate, the evidence and detailed procedures used in establishing the corner positions and monumentation found or placed.) RE ESTABLISHED THE SOUTHEAST QUARTER OF THE SOUTHEAST QUARTER
Monument Description and Remarks: OF SECTION 13 USING EVIDENCE FOUND IN THE FIELD MONUMENTING THE BOUNDARY OF THE QUARTER QUARTER. IRON RODS
AND CRIMP PIPE MONUMENTING VARIOUS SURVEYS IN THE SUBDIVIDED PORTION OF THE SOUTHEAST QUARTER.

LATITUDE AND LONGITUDE DETERMINED BY USING GPS MONUMENT IN THE IOWA HARN NETWORK AS PUBLISHED BY
NATIONAL GEODETIC SURVEY.



PLAN - VIEW

(Show a minimum of three reference ties to durable physical objects, relevant monuments and physical conditions which will enable recovery of the corner)

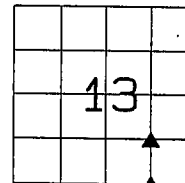

NW CORNER
SE 1/4 SE 1/4
SEC 13-89-13
SET: 5/8" REBAR
W/YELLOW CAP#6807

SW CORNER
SE 1/4 SE 1/4
SEC 13-89-13
CUT "X" IN CONC.
APROX. 4 4

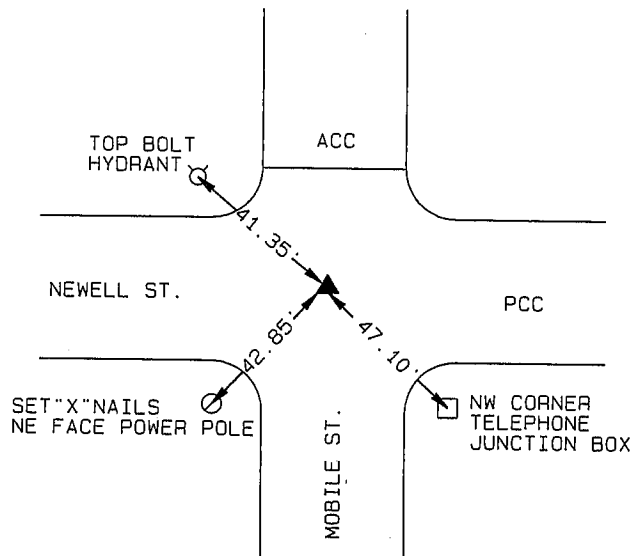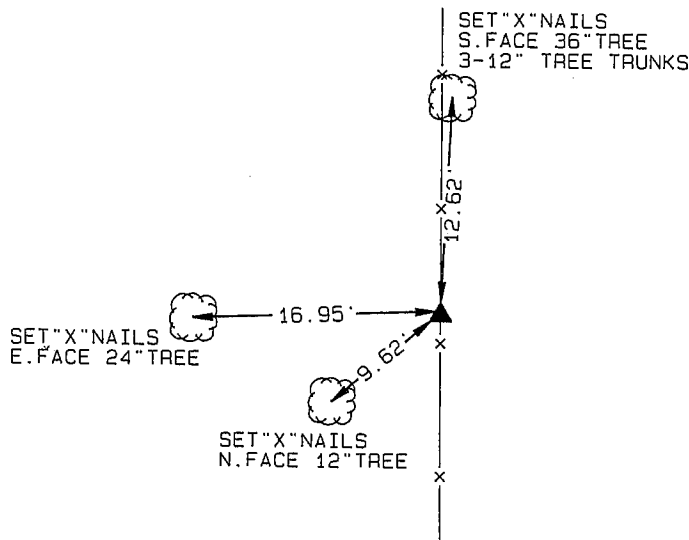

LATITUDE = 42°30'59.71906"N
LONGITUDE = 92°19'22.12766"W
ELLIPSOID HEIGHT =


LATITUDE = 42°30'46.63844"N
LONGITUDE = 92°19'22.31734"W
ELLIPSOID HEIGHT =

I hereby certify that this land surveying document was prepared and the related work was performed by me or under my direct personal supervision and that I am a duly licensed Land Surveyor under the laws of the State of Iowa.

Signed *Garry G. Sadoris* Date 2/4/03

Garry G. Sadoris, L.S.
Iowa License No. 6807

My registration renewal date is December 31, 2003

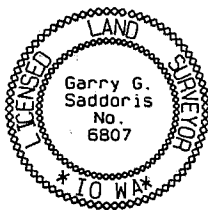

List Corners to be Indexed

Corners	Section	Township	Range
SW CORNER SE 1/4 SE 1/4	13	89	13
NW CORNER SE 1/4 SE 1/4	13	89	13
NW CORNER NE 1/4 NE 1/4	24	89	13
SW CORNER NE 1/4 SE 1/4	13	89	13
SE CORNER NW 1/4 SE 1/4	13	89	13
NE CORNER SW 1/4 SE 1/4	13	89	13
SE CORNER SW 1/4 SE 1/4	13	89	13
NE CORNER NW 1/4 NE 1/4	24	89	13