

INDEX

BLACK HAWK COUNTY, IOWA:SS

FEE BOOK # 2006 21039

PROOF

FILED FOR RECORD MAR 2

2006

AT 2:00 P.M.

FEE 1-5.00-1.00/

COMPARED

Patricia A. Deas

BLACK HAWK COUNTY RECORDER

KESS & ASSOCIATES INC

Kirk D. Eschliman, P.L.S. Iowa Lic. No. 9961, 723 Broadway Street, Waterloo, Iowa 50703 - Phone: 319-234-0509

UNITED STATES PUBLIC LAND SURVEY CORNER CERTIFICATE OF

LAND SURVEY MONUMENTS SITUATED IN SECTION FOURTEEN (14), TOWNSHIP EIGHTY-NINE (89) NORTH
RANGE THIRTEEN (13) WEST OF THE FIFTH PRINCIPAL MERIDIAN, BLACK HAWK COUNTY, IOWA.
PREVIOUSLY RECORDED IN (NOT PREVIOUSLY RECORDED) (BOOK, PAGE, DOCUMENT NUMBER, ETC.) IN THE COUNTY RECORDER'S OFFICE.


(SHOW REASON FOR PREPARING THIS CERTIFICATE, THE EVIDENCE AND DETAILED PROCEDURES USED IN ESTABLISHING THE CORNER POSITIONS AND MONUMENTATION FOUND OR PLACED.)

MONUMENT DESCRIPTION AND REMARKS:

CURRENT SECTION CORNER CERTIFICATE NOT ON FILE IN THE BLACK HAWK COUNTY RECORDER'S OFFICE

FOUND BENT NO. 5 REBAR, THREE INCHES BELOW SURFACE OF ASPHALT LOUISE STREET.

SECTION CORNER USED FOR A SURVEY IN SW 1/4, NE 1/4, SEC. 14, T89N, R13W COMPLETED ON JAN. 23, 2006.

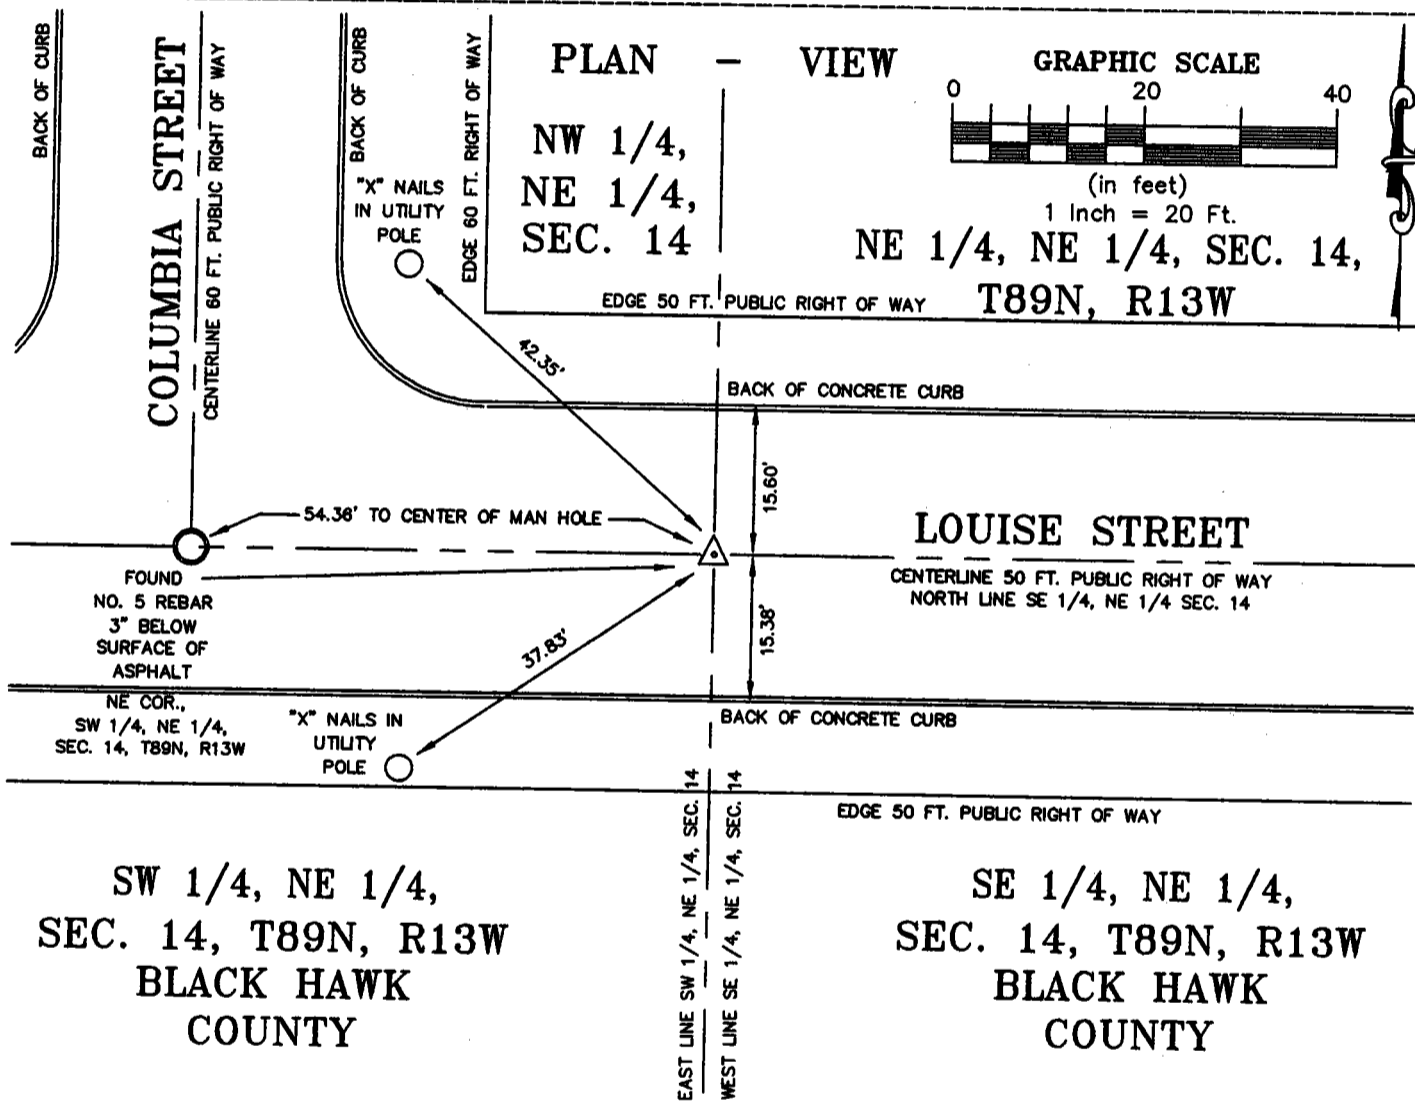

I HEREBY CERTIFY THAT THIS LAND SURVEYING DOCUMENT
WAS PREPARED AND RELATED SURVEY WORK WAS
PERFORMED BY ME OR UNDER MY DIRECT PERSONAL
SUPERVISION AND THAT I AM A DULY LICENSED LAND
SURVEYOR UNDER THE LAWS OF THE STATE OF IOWA.

Kirk D. Eschliman DATE: 01/31/2006
KIRK D. ESCHLIMAN, P.L.S. IOWA LIC. NO. 9961
MY LICENSE RENEWAL DATE IS DECEMBER 31, 2007
PAGES OR SHEETS COVERED BY THIS SIGNATURE & SEAL: SHEET 1 OF 1

FOR: SHULTZ INDUSTRIES, INC.
1500 DAVID STREET
WATERLOO, IOWA 50703

REQ. BY: BEN DEYOUNG
WATERLOO, IOWA




KESS & ASSOCIATES, INC.
PROFESSIONAL LAND SURVEYORS : 723 BROADWAY, WATERLOO, IOWA 50703-5811

DATE: 01/23/2006 C.A.D.D. FILE: 05C42SCC5.DWG PROJECT NO.: 05C42

List of corners to be indexed:

Corner	Section	Township	Range
NE COR.,	SW 1/4, NE 1/4, SEC. 14,	T89N,	R13W

SECTION 14

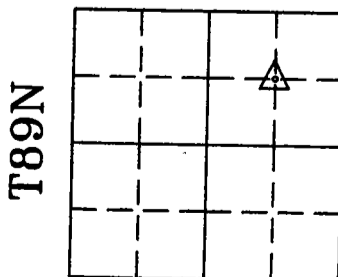

R13W

File Number: 2006 00021039 Seq: 1