

Doc ID: 007202030001 Type: GEN Recorded: 11/08/2016 at 12:24:27 PM Fee Amt: \$7.00 Page 1 of 1 Black Hawk County Iowa SANDIE L. SMITH RECORDER


File 2017-00008990

* WAYNE CLAASSEN ENGINEERING AND SURVEYING, INC. P.O. BOX 898 WATERLOO, IOWA 50704-0898

PHONE: (VOICE) 319-235-6294 (FAX) 319-235-0028

UNITED STATES PUBLIC LAND SURVEY CORNER CERTIFICATE

Land Survey Monuments sit		 ownship Black Hawk			
Previously recorded in	pook, page, document number, etc.) Remarks	in C	County R	decorder's	Office.

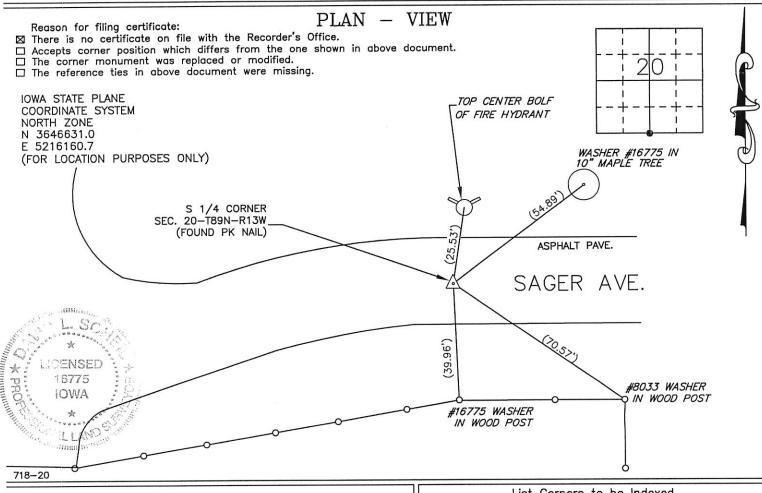

I hereby certify that this land surveying document was prepared and the related survey work was performed by me or under my direct personal supervision and that I am a duly Licensed Land Surveyor under the laws of the State of lowa.

Signature:

David L. Scheil, L.S.

Date:

		List	Corners to b	e Indexed	
S	157-017	orners CORNER,	Section 20	Twp 89 N	Range 13 W
N	1/4	CORNER,	29	89 N	13 W