

PREPARED BY & RETURN TO TERRY COADY, SNYDER & ASSOCIATES, INC. 2727 SW SNYDER BLVD, ANKENY, IOWA 50023 (515) 964-2020


Land Survey Monuments situated in Section 29, Township 89, Range 13, West of the Fifth Principal Meridian, BLACK HAWK County, Iowa. Previously recorded in Book 2007, Page 26179 in County Recorder's Office. (book, page, document number, ect.)

(Show reason for preparing this certificate, the evidence and detailed procedures used in establishing the corner positions and monumentation found or placed.)


Monument Description and Remarks:
SE CORNER SW 1/4 NW 1/4 SECTION 29-89-13
FOUND PK NAIL (HEAD OF NAIL MISSING) IN CONCRETE USING RECORDED CORNER CERTIFICATE IN BOOK 2007 PAGE 26179 PRIOR TO CEDAR HEIGHTS DRIVE RECONSTRUCTION PROJECT. AFTER CONSTRUCTION, RESET SECTION CORNER IN SAME LOCATION USING PROJECT COORDINATES AND SET A CUT "X" IN CONCRETE. THIS CERTIFICATE IS BEING FILED BECAUSE THE PREVIOUS MONUMENT AND TIES HAVE BEEN DESTROYED DUE TO THE CONSTRUCTION OF THE CEDAR HEIGHTS DRIVE RECONSTRUCTION PROJECT.

Plan-View

(Show a minimum of three reference ties to durable physical objects, relevant monuments and physical conditions that will enable recovery of the corner.)

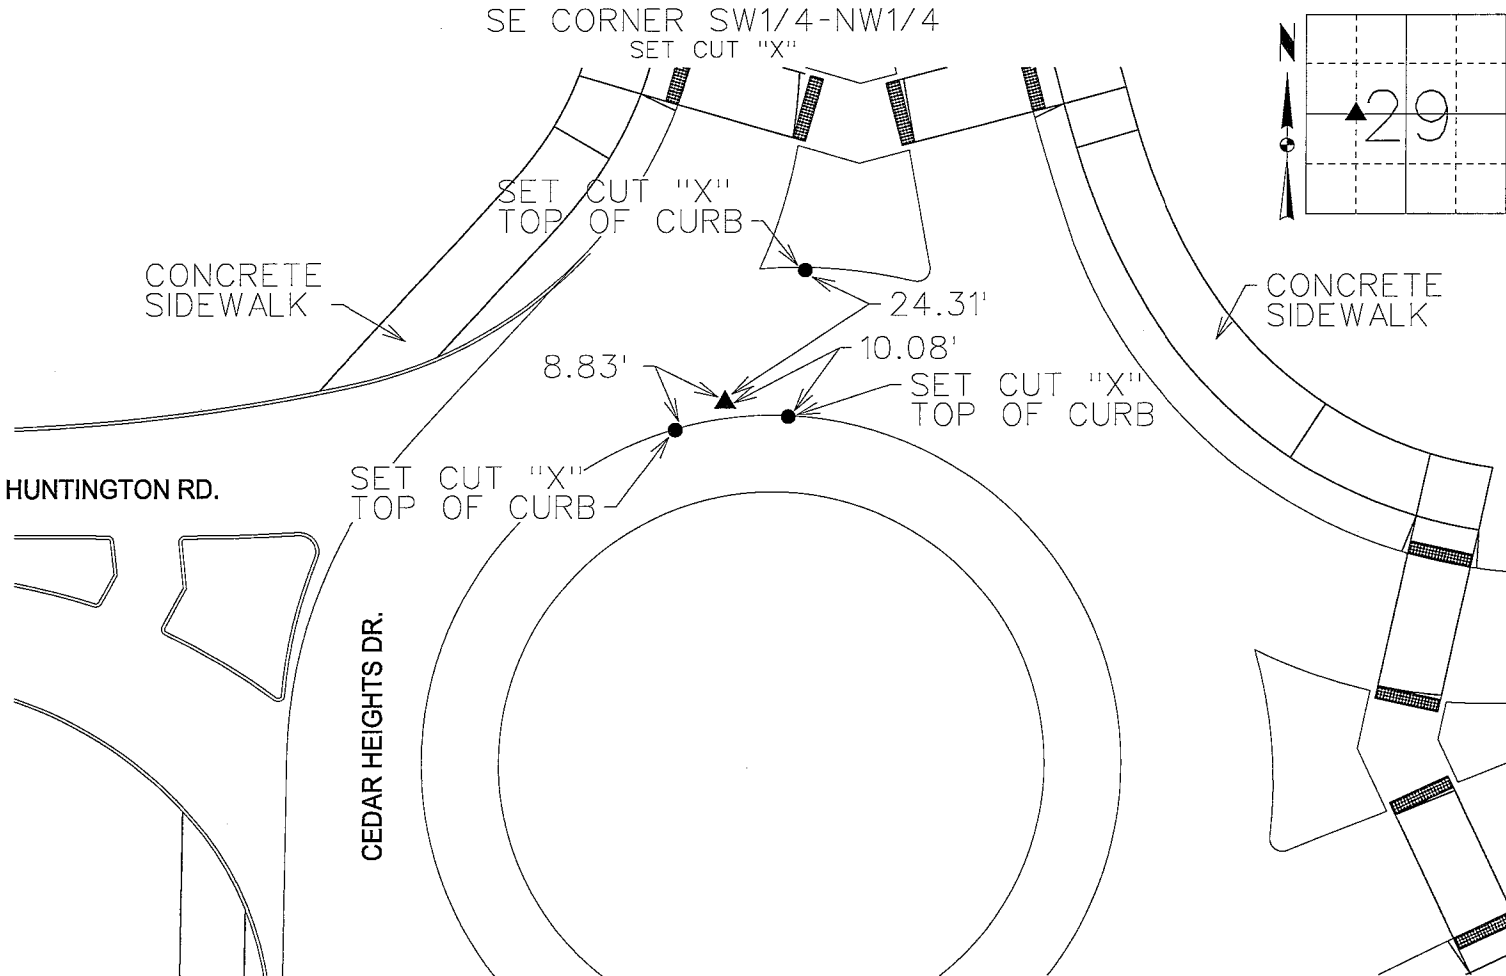

NOTE: ALL DISTANCES MEASURED HORIZONTAL UNLESS OTHERWISE NOTED.

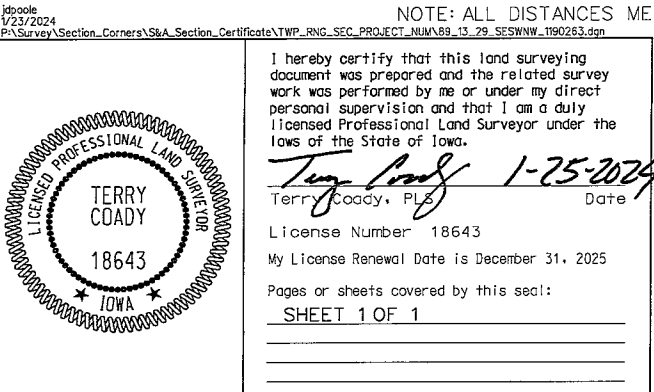

List Corners to be Indexed			
Corners	Section	Twp	Range
SE CORNER SW1/4-NW1/4	29	89	13
TECH: JDP			
PN: 119.0263.08		DATE: 11-29-23	