


File **2018-00015640**

United States Public Land Survey Corner Certificate of

No previous corner certificate recorded.

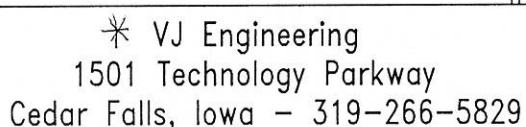

Section Corner
Reference Ties

file no.	178070
drawn by	MAK
date	3-26-18