

WAYNE CLAASSEN ENGINEERING AND SURVEYING, INC.
P.O. BOX 898 WATERLOO, IOWA 50704-0898


PHONE: (VOICE) 319-235-6294
(FAX) 319-235-0028

UNITED STATES PUBLIC LAND SURVEY CORNER CERTIFICATE

Land Survey Monuments situated in Section 30, Township 89 North, Range 13 West, of the Fifth Principal Meridian, Black Hawk County, Iowa.
Previously recorded in _____ in County Recorder's Office.
(book, page, document number, etc.)

Monument Description and Remarks

No certificate on file. Found 'X' cut in concrete pavement as per ties from Orchard Hill 4th Addition. Corner certificate filed in Misc. Book 337-073 shows ties to the "S 1/4 corner of Sec. 19-89-13". this is mislabeled and should be labeled "the Southeast corner of SW 1/4 of the SE 1/4 of Sec. 19-89-13" which is the same corner as represented in this certificate.

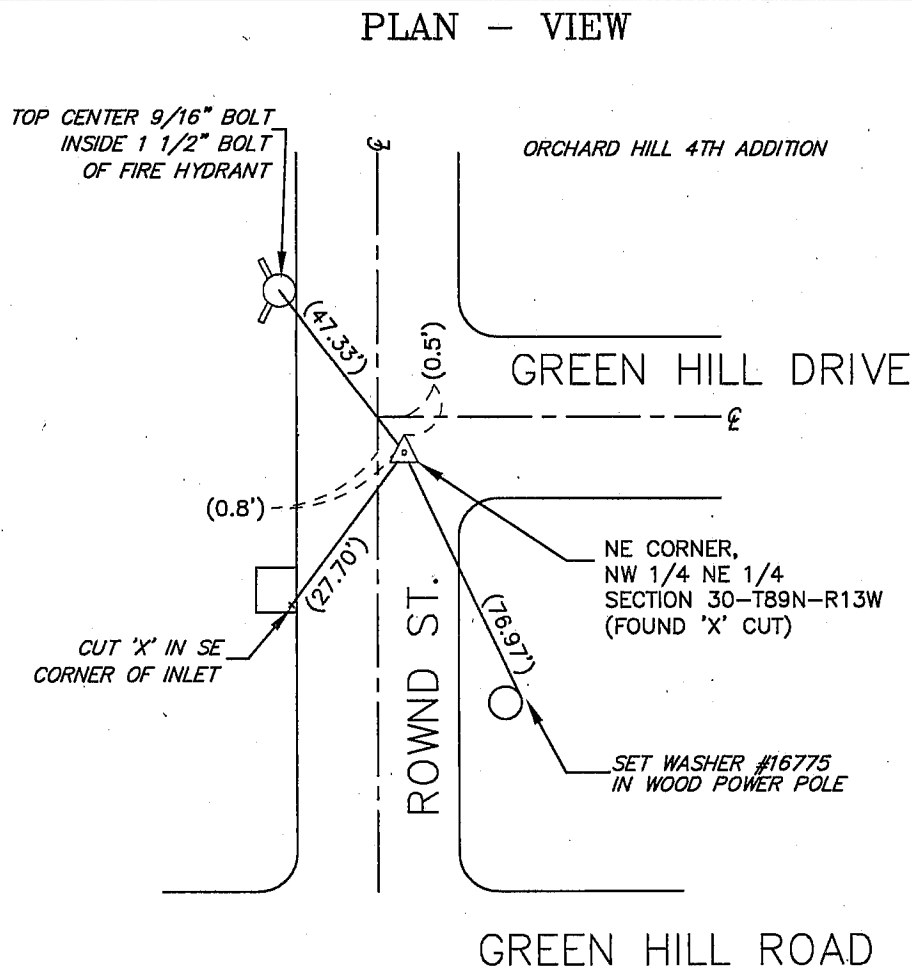

BK 573, PG. 78

I hereby certify that this land surveying document was prepared and the related survey work was performed by me or under my direct personal supervision and that I am a duly Licensed Land Surveyor under the laws of the State of Iowa.

Signature: _____

David L. Scheil, L.S.

Date: FEB. 12, 2009 Lic. No. 16775

Pages or Sheets Covered by this Seal: THIS SHEET ONLY.


My license renewal date is December 31, 2010

SEAL

List Corners to be Indexed

Corners	Section	Twp	Range
NE CORNER, NW 1/4 NE 1/4	30	89 N	13 W

SE CORNER, SW 1/4 SE 1/4	19	89 N	13 W
--------------------------	----	------	------

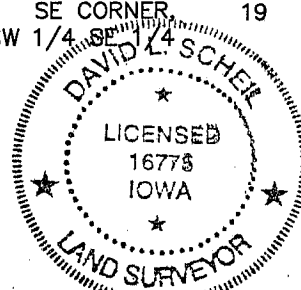


