



Doc ID: 003662190001 Type: GEN  
 Recorded: 02/13/2009 at 10:50:46 AM  
 Fee Amt: \$7.00 Page 1 of 1  
 Instr# 200800016947  
 Black Hawk County Iowa  
 JUDITH A MCCARTHY RECORDER  
 Book 1080 Page 14301 - 14301  
 File **2009-00014809**

WAYNE CLAASSEN ENGINEERING AND SURVEYING, INC.  
 P.O. BOX 898 WATERLOO, IOWA 50704-0898

PHONE: (VOICE) 319-235-6294  
 (FAX) 319-235-0028

**UNITED STATES PUBLIC LAND SURVEY CORNER CERTIFICATE**


Land Survey Monuments situated in Section 30, Township 89 North, Range 13 West, of the Fifth Principal Meridian, Black Hawk County, Iowa.

Previously recorded in \_\_\_\_\_ in County Recorder's Office.  
 (book, page, document number, etc.)

**Monument Description and Remarks**

No certificate on file. 1 1/2" diameter open pipe found in Dec./2000 that was used for Green Creek Addition subdivision. Same 1 1/2" diameter open pipe found in August/2001 for Parcel "C". December 2002, 1 1/2" diameter open pipe destroyed due to construction of Rownd St. & Green Creek Road. Found pin & yellow cap #8033 in same position as missing 1 1/2" diameter pipe.

**PLAN - VIEW**

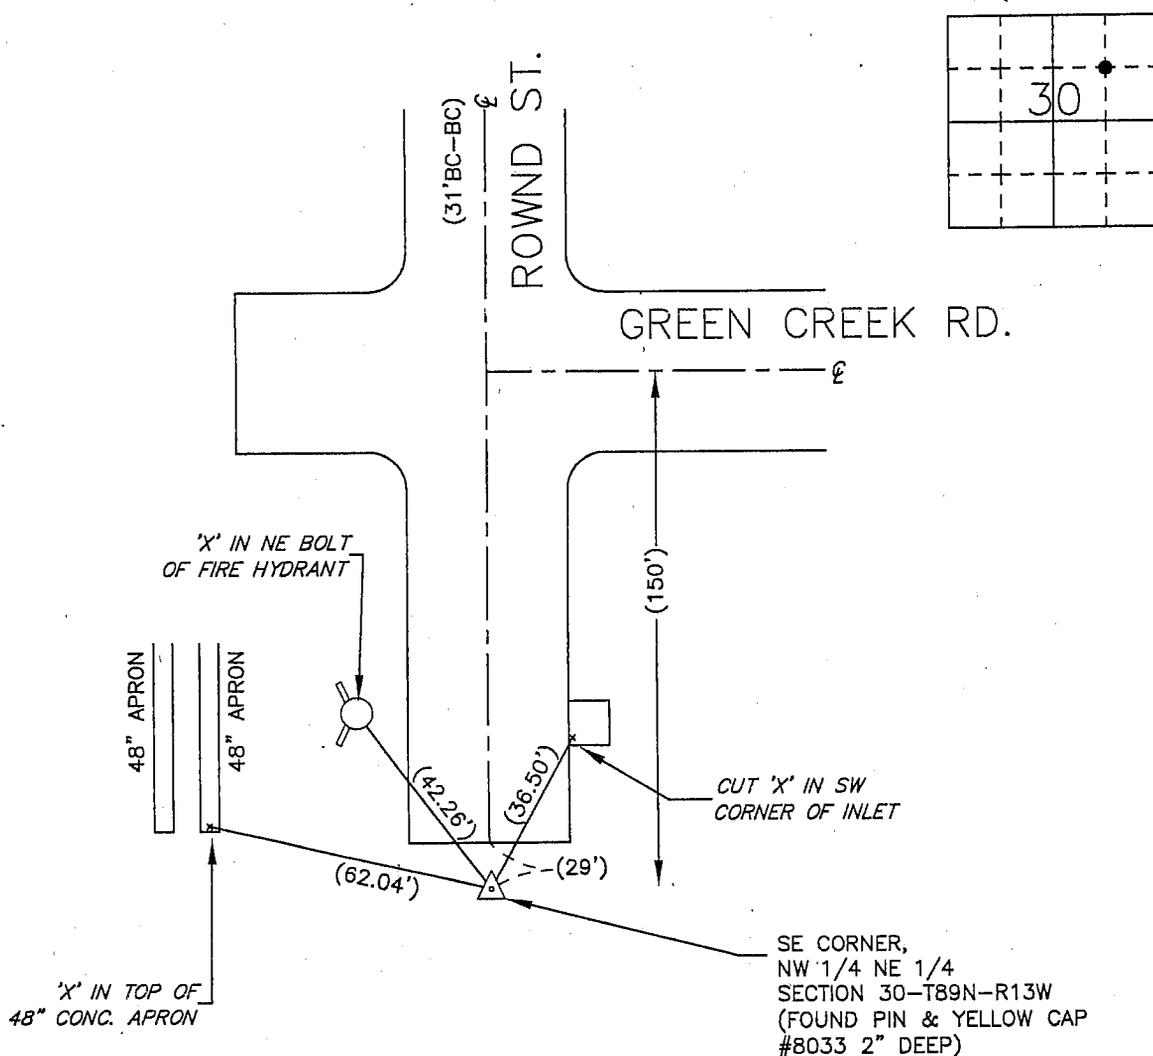

BK 573, PG. 78

I hereby certify that this land surveying document was prepared and the related survey work was performed by me or under my direct personal supervision and that I am a duly Licensed Land Surveyor under the laws of the State of Iowa.

Signature: David L. Scheil

David L. Scheil, L.S.

Date: FEB. 12, 2009 Lic. No. 16775


Pages or Sheets Covered by this Seal: THIS SHEET ONLY.

My license renewal date is December 31, 2010

SEAL

List Corners to be Indexed

Corners	Section	Twp	Range
SE CORNER, NW 1/4 NE 1/4	30	89 N	13 W

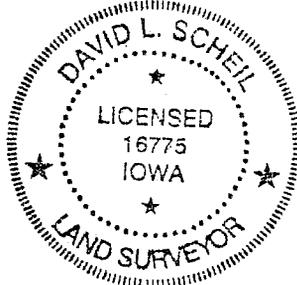

*Handwritten:* 2/13/09  
 21081 \$1400