SLSI 9-90

UNITED STATES PUBLIC LAND SURVEY CORNER CERTIFICATE

OF

Land Survey Monuments situated in Section 30, Township 89 N, Range 13W, of the Fifth Principal Meridian, Black Hawk County, Iowa.
Previously recorded in N/A (book, page, document number, etc.) in County Recorder's Office.

(Show reason for preparing this certificate, the evidence and detailed procedures used in establishing the corner positions and monumentation found or placed.)

Monument Description and Remarks: FOUND LEAD PLUG WITH TACK @ 10.7' WEST OF ℄ PAVING DEERE ROAD. THIS POINT WAS SET AS A PART OF THE DEERE ROAD PAVING PROJECT 1981-1982. RIGHT OF WAY ACQUISITION PLAT IS SHOWN IN L.D. 544 AT PAGE 4 DATCHES THIS LOCATION.

PLAN - VIEW

(Show a minimum of three reference ties to durable physical objects, relevant monuments and physical conditions that will enable recovery of the corner.)

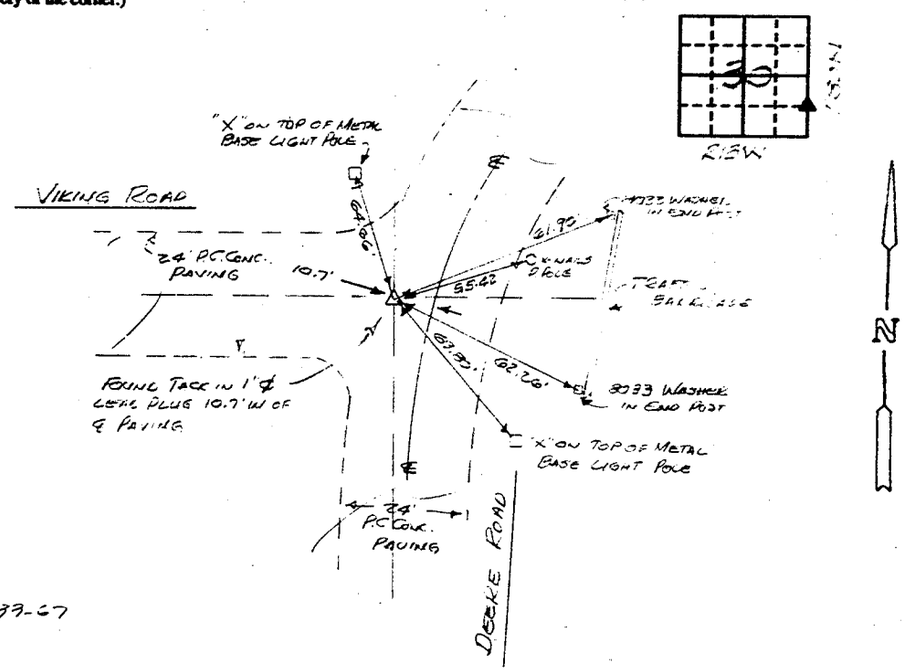

I hereby certify that the survey work was completed and this certificate was prepared by me or under my direct personal supervision and that I am a duly registered land surveyor under the laws of the state of Iowa.

Signature: F. William King
Name typed or printed: F. WILLIAM KING
Date: 7-31-1991 Reg. No. 8033

SEAL

F. WILLIAM KING ★ REGISTERED 8033 IOWA ★ LAND SURVEYOR

List Corners to be Indexed

Corners	Section	Twp	Range
NE COR. OF SE¼SE¼	30	89N	13W