

RECEIVED 5.00  
FEE 2.00  
TRANSFER  
RECEIVED  
CP  
Jm

Doc ID: 005656380001 Type: GEN  
Recorded: 01/08/2015 at 01:35:45 PM  
Fee Amt: \$7.00 Page 1 of 1  
Black Hawk County Iowa  
SANDIE L. SMITH RECORDER  
File 2015-00011095

Paul H. Helland, 1107 Technology Parkway, Cedar Falls, Iowa 50613-6951, (319)-266-0161

## UNITED STATES PUBLIC LAND SURVEY CORNER CERTIFICATE OF

LAND SURVEY MONUMENTS SITUATED IN SECTION NO. 30, TOWNSHIP NO. 89 NORTH, RANGE  
NO. 13 WEST OF THE FIFTH PRINCIPAL MERIDIAN, BLACK HAWK COUNTY, IOWA.  
PREVIOUSLY RECORDED IN DOC. NO. 200900008589

(SHOW REASON FOR PREPARING THIS CERTIFICATE, THE EVIDENCE AND DETAILED PROCEDURES USED IN ESTABLISHING THE  
CORNER POSITIONS AND MONUMENTATION FOUND OR PLACED.)


### MONUMENT DESCRIPTION AND REMARKS:

ONLY ONE REFERENCE TIE REMAINS. SURVEY COMPLETED IN THE SW 1/4 SW 1/4 OF SEC. 29-T89N-R13W.

→ **NE CORNER SW 1/4 SW 1/4:** USPLSCC DOCUMENT NUMBER 2009008589 DATED 10/24/2008 CALLS FOR [LEAD PLUG IN  
ABOVE REFERENCE (MISC. BK 297 PG 173) WAS DESTROYED DUE TO "ROUNDABOUT" CONSTRUCTION JUST NORTH ON  
CEDAR HEIGHTS DRIVE. SET 1/2" X 24" STEEL REBAR WITH RED PLASTIC CAP #16775 USING REMAINING TIES HELD  
FROM TRAFFIC BARRICADE FROM ABOVE REFERENCE]. FOUND NO. 4 REBAR w/RPC #16775.

### PLAN VIEW

(SHOW A MINIMUM OF THREE REFERENCE TIES TO DURABLE PHYSICAL OBJECTS, RELEVANT MONUMENTS AND PHYSICAL  
CONDITIONS THAT WILL ENABLE RECOVERY OF THE CORNER.)

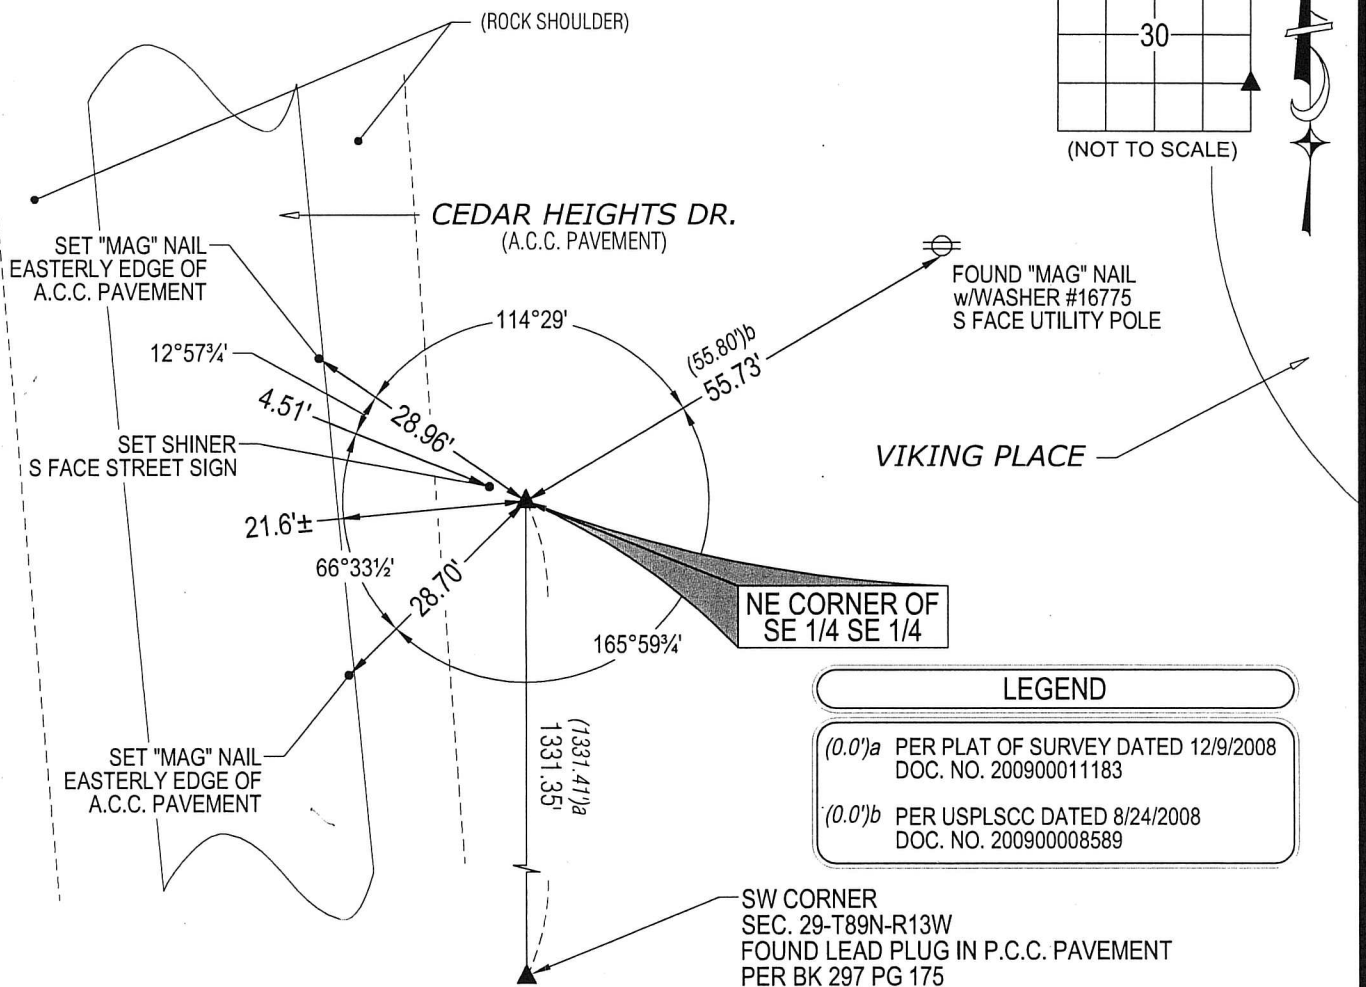


(BEARINGS ARE ASSUMED)



HELLAND ENGINEERING & SURVEYING, LTD.  
1107 Technology Parkway  
Cedar Falls, Iowa 50613-6951  
(319)-266-0161

SHINER = 8d. NAIL & 1 5/16"Ø METAL SHINER  
BRASS TAG = 8d. NAIL & 13/16"Ø BRASS TAG  
OPC = PLASTIC CAP (O=ORANGE, R=RED, Y=YELLOW)  
(00') RECORDED AS FILE NAME: 14-220-54.DWG

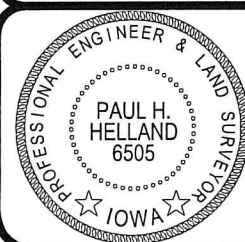

I hereby certify that this land surveying document was prepared  
and the related survey work was performed by me or under my  
direct personal supervision and that I am a duly licensed  
Professional Land Surveyor under the laws of the State of Iowa.

Paul H. Helland  
License Number 6505  
My license renewal date is December 31, 2015.  
All pages or sheets are covered by this seal except:

### LIST CORNERS TO BE INDEXED

CORNER	SECTION	TOWNSHIP	RANGE
NE COR. SE 1/4 SE 1/4	30	89N	13W
SE COR. NE 1/4 SE 1/4	30	89N	13W
SW COR. NW 1/4 SW 1/4	29	89N	13W
NW COR. SW 1/4 SW 1/4	29	89N	13W