

# UNITED STATES PUBLIC LAND SURVEY CORNER CERTIFICATE

OF


Land Survey Monuments situated in Section 31, Township 89N, Range 13W of the Fifth Principal Meridian, BLACK HAWK County, Iowa.  
Previously recorded in N/A (book, page, document number, etc.) in County Recorder's Office.

(Show reason for preparing this certificate, the evidence and detailed procedures used in establishing the corner positions and monumentation found or placed.)

Monument Description and Remarks: FOUND LEAD PLUG WITH TACK @ 9.9' EAST OF  
E 24' P.C. PAVING. THIS POINT WAS SET AS A PART OF THE DEDRE FORD PAVING  
PROJECT 1981-1982. RIGHT OF WAY ACQUISITION PLAT RECORDED LD 544 AT PAGE 2  
WITNESSES THIS LOCATION.

## PLAN - VIEW

(Show a minimum of three reference ties to durable physical objects, relevant monuments and physical conditions that will enable recovery of the corner.)

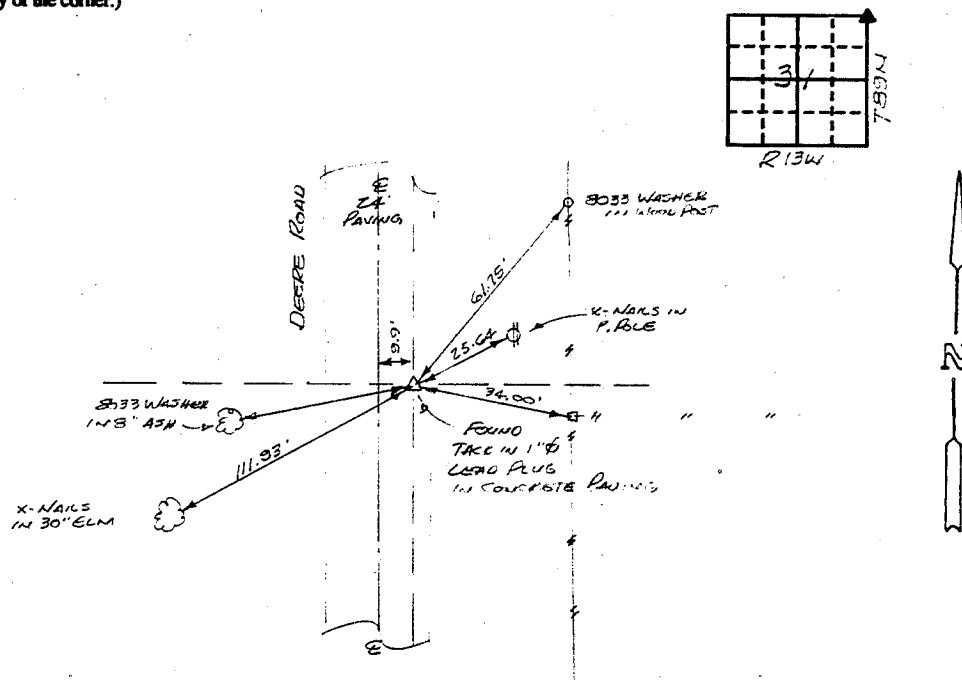

333-67

I hereby certify that the survey work was completed and this certificate was prepared by me or under my direct personal supervision and that I am a duly registered land surveyor under the laws of the state of Iowa.

Signature: F. William King  
Name typed or printed: F. WILLIAM KING  
Date: 7-31-1991 Reg. No. 8033

SEAL



| Corners | List Corners to be Indexed | Section | Twp | Range |
|---------|----------------------------|---------|-----|-------|
| NE      | 31                         | 89N     | 13W |       |