

SLSI 9-90

# UNITED STATES PUBLIC LAND SURVEY CORNER CERTIFICATE

OF

Land Survey Monuments situated in Section 31, Township 89N, Range 13W, of the Fifth Principal Meridian, BLACK HAWK County, Iowa.  
Previously recorded in N/A in County Recorder's Office.


(book, page, document number, etc.)

(Show reason for preparing this certificate, the evidence and detailed procedures used in establishing the corner positions and monumentation found or placed.)

Monument Description and Remarks: FOUND 1 1/2" Ø LEAD PLUG 13.3' NORTH OF  
SOUTH BACK CURB LINE RIDGEWAY AVENUE. THIS POINT WAS SET AS  
A PART OF THE 1979-1980 RIDGEWAY AVE. PAVING PROJECT.

## PLAN - VIEW

(Show a minimum of three reference ties to durable physical objects, relevant monuments and physical conditions that will enable recovery of the corner.)

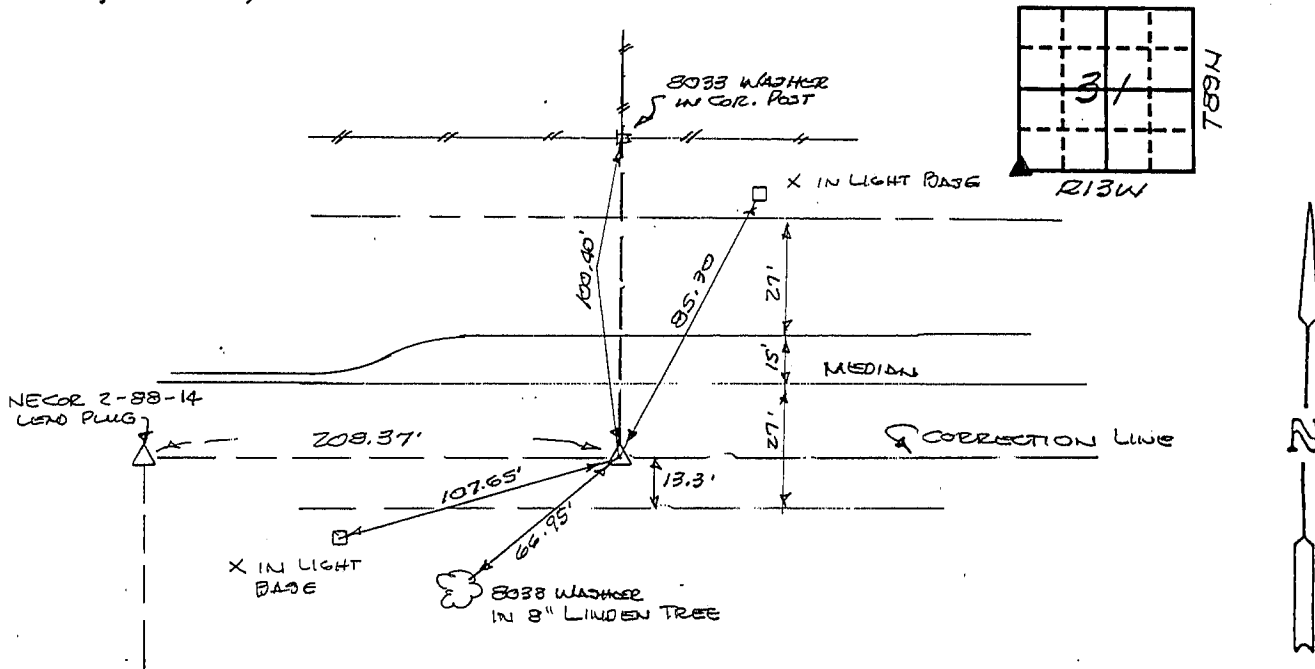

333-70

I hereby certify that the survey work was completed and this certificate was prepared by me or under my direct personal supervision and that I am a duly registered land surveyor under the laws of the state of Iowa.

Signature: F. William King  
Name typed or printed: F. WILLIAM KING  
Date: 8-1-1991 Reg. No. 8033



SEAL

Corners List Corners to be Indexed  
Section Twp Range  
31 89N 13W

(AS 88) (SEE ATTACHED)  
per Below

Twk  
Rev'd 3-28-01

MISC. BK. 297 p. 183