

UNITED STATES PUBLIC LAND SURVEY CORNER CERTIFICATE OF

Land Survey Monuments situated in Section 32, Township 89N, Range 13W, of the Fifth Principal Meridian, BLACK HAWK County, Iowa.
Previously recorded in 111A in County Recorder's Office.


(Book, page, document number, etc.)

(Show reason for preparing this certificate, the evidence and detailed procedures used in establishing the corner positions and monument found or placed.)

Monument Description and Remarks: FOUND STD. CONCRETE MONUMENT 22" DIAM WITH
CLIP PIN @ NW CORNER. PUT MAGNET IN HOLE, 11" DEEP @ NE COR, & SET 3/4"
CLIP PIN OVER TOP. (IN CULTIVATED FIELD). MONUMENT FOUND IN 1971 CLASSIFIED
EXCEL. SURVEY FOR CITY OF WATERLOO.

PLAN - VIEW

(Show a minimum of three reference ties to durable physical objects, relevant monuments and physical conditions that will enable recovery of the corner.)

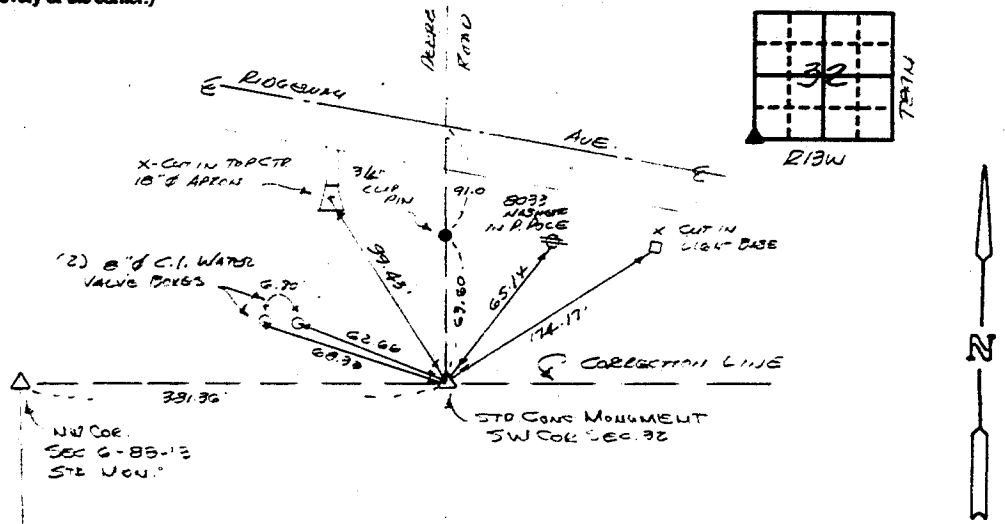

339-9

I hereby certify that the survey work was completed and this certificate was prepared by me or under my direct personal supervision and that I am a duly registered land surveyor under the laws of the state of Iowa.

Signature: F. Williams
Name typed or printed: F. WILLIAMS KING
Date: 8-1-1991 Reg. No. 8033



SEAL

Corners	List Corners to be Indexed	Section	Twp	Range
SW	32	89N	13W	