

UNITED STATES PUBLIC LAND SURVEY CORNER CERTIFICATE

SLSI 9-90

OF



(book, page, document number, etc.)
Show reason for preparing this certificate, the evidence and detailed procedures used in establishing the corner positions and monumentation found or placed.)

Monument Description and Remarks: Cut "X" in cast iron MH lid using cut marks in MH ring casting. Ties provided by Price Petrides Assoc. Engrs, Waterloo. This corner was referenced by BP Assoc. in the course of Ansborg Ave Paving Project. (3) Reference monuments were found stamped 1, 2 & 3.

PLAN - VIEW

(Show a minimum of three reference ties to durable physical objects, relevant monuments and physical conditions that will enable recovery of the corner.)

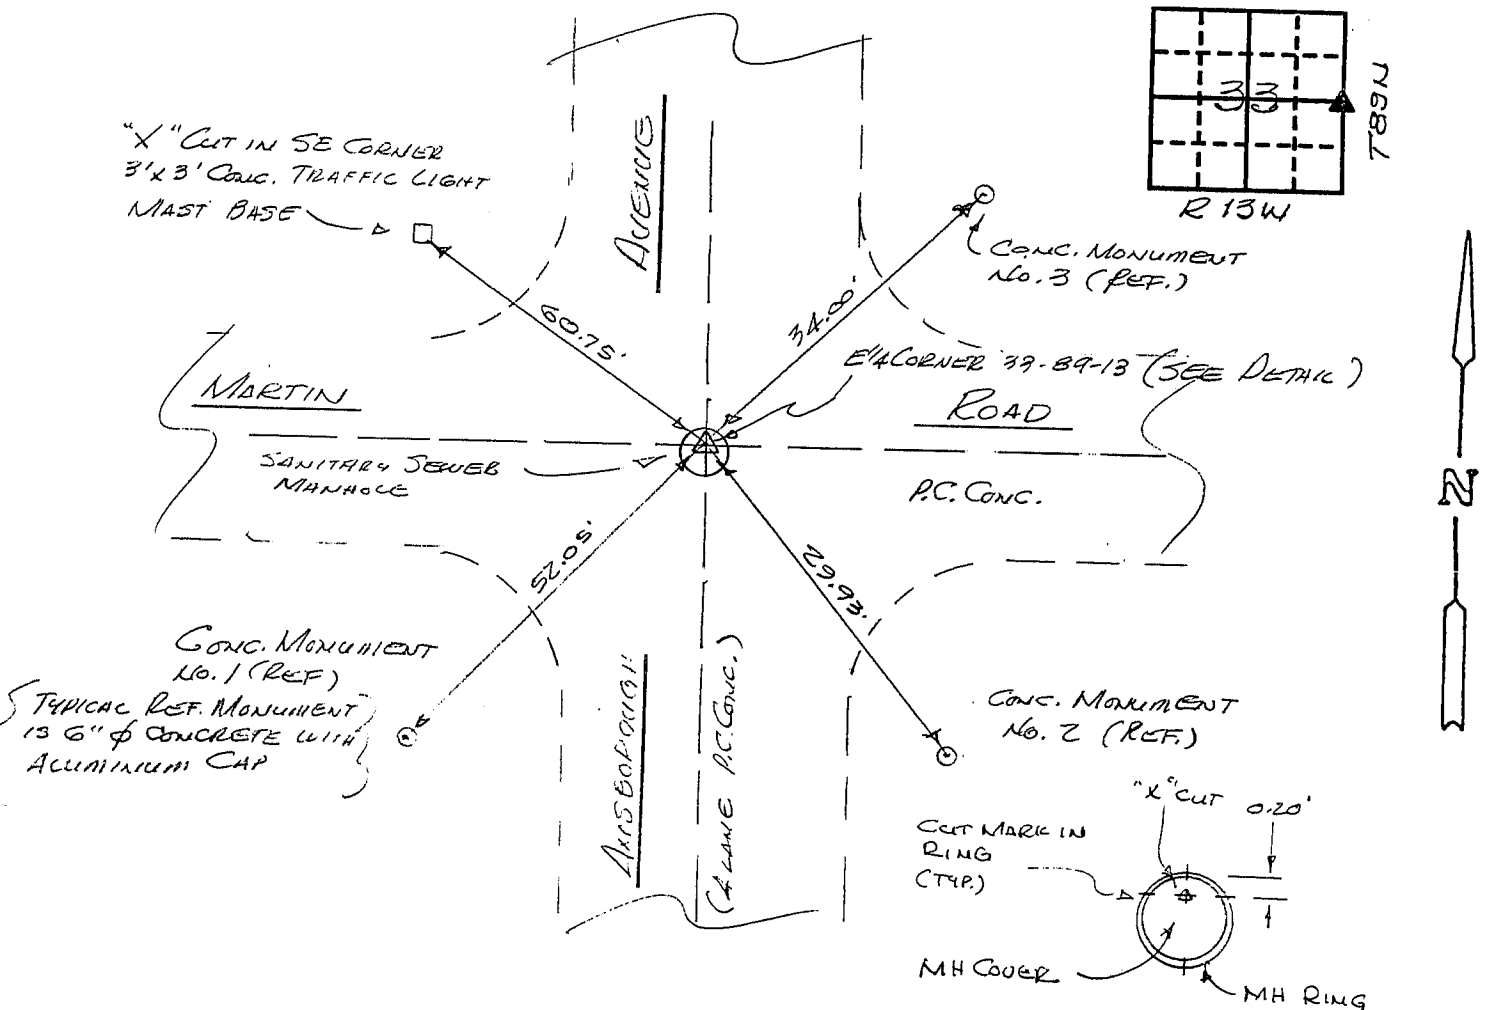

I hereby certify that the survey work was completed and this certificate was prepared by me or under my direct personal supervision and that I am a duly registered land surveyor under the laws of the state of Iowa.

Signature: F. William King
Name typed or printed: F. WILLIAM KING
Date: 5-10-1991 Reg. No. 8033



Corners	List Corners to be Indexed	Section	Twp	Range
E/4	33	89N	13W	

MISC. BK. 295 P. 954