

Misc
INDEX
MARGIN
PROOF
COMPARE

DECK HAWK COUNTY IOWA
Filed for record Dec 28, 19 98 at 15073
4:00 P.M. and recorded in Book 332
of Misc Page 906
Recorder
FEE 1-5.00/
WAYNE CLAASSEN ENGINEERING

WAYNE CLAASSEN ENGINEERING AND SURVEYING, INC.
P.O. BOX 898 WATERLOO, IOWA 50704-0898

PHONE: (VOICE) 319-235-6294
(FAX) 319-235-0028

UNITED STATES PUBLIC LAND SURVEY CORNER CERTIFICATE


Land Survey Monuments situated in Section 33, Township 89N, Range 13W, of the Fifth Principal Meridian, BLACK HAWK County, Iowa.
Previously recorded in N/A in County Recorder's Office.
(book, page, document number, etc.)

(Show reason for preparing this certificate, the evidence and detailed procedures used in establishing the corner positions and monumentation found or placed.)

Monument Description and Remarks FOUND LEAD PLUG IN CONCRETE PAVING AT E MARTIN ROAD & RIDGEWAY AVE. SW CORNER 33-89-13. LOCATION AGREES WITH CED SURVEY WORK 1971.

PLAN - VIEW

(Show a minimum of three reference ties to durable physical objects, relevant monuments and physical conditions that will enable recovery of the corner.)

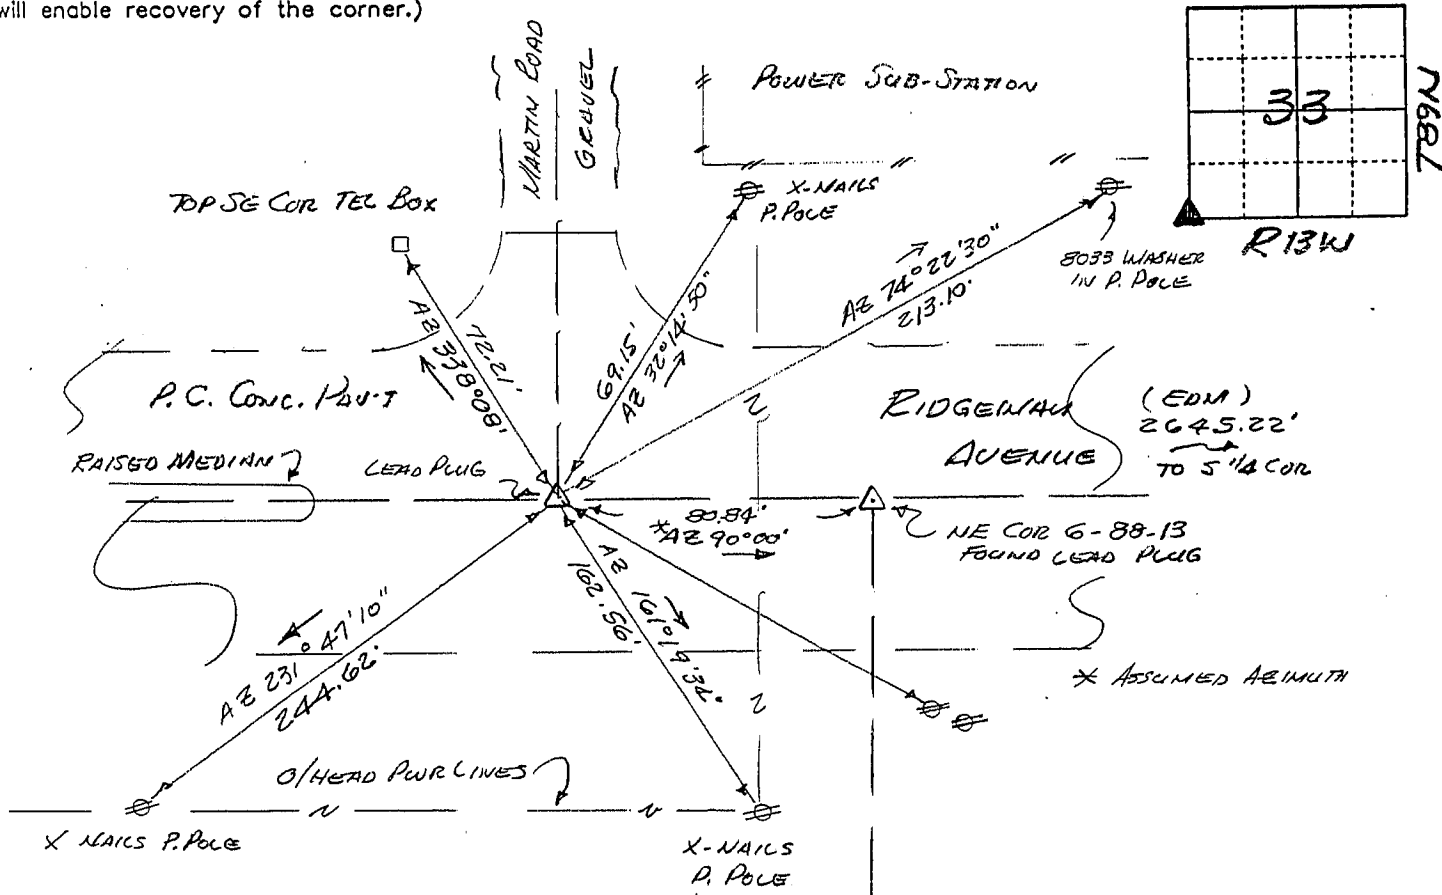

433-38
(127-4)

I hereby certify that the survey work was completed and this certificate was prepared by me or under my direct personal supervision and that I am a duly licensed land surveyor under the laws of the state of Iowa.

Signature:


(Name typed or printed:) F. WILLIAM KING

Date:

DEC. 24, 1998

Lic. No.

8033

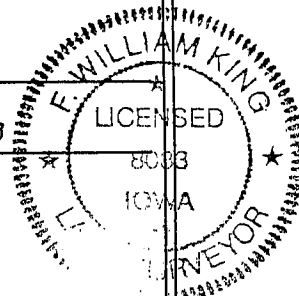

List Corners to be Indexed

Corners	Section	Twp	Range
SW	33	89N	13W

SEAL

BOOK 332 PAGE 906