Document Number: 2008026192 Jun 27, 2008 1:42:41 pm

0.00

1.00

Date:

Trans Tax:

Rec Fee:

Rec Management Fee:

1.00

E-Com Fee:

Non-Standard Page Fee:

0.00

Z

Filed for record in Black Hawk County, Iowa Judith A. McCarthy, County Recorder

WAYNE CLAASSEN ENGINEERING AND SURVEYING, INC. P.O. BOX 898 WATERLOO, IOWA 50704-0898

PHONE: (VOICE) 319-235-6294 (FAX) 319-235-0028

UNITED STATES PUBLIC LAND SURVEY CORNER CERTIFICATE

Land Survey Monuments	situated in Section _	35 ,	Township	89 North , Range
13 West,	of the Fifth Principal	Meridian,	Black Hawk	County, lowc
Previously recorded in _	(book, page, document number, o	etc.)	in County	Recorder's Office

Monument Description and Remarks oct., 1940. WPA NOTES SHOW "FOUND LARGE GRANITE BOULDER BUT NOTHING TO GIVE EVIDENCE THAT STONE WAS THE CORNER. ESTABLISHED CORNER 2640.8' FROM SW. COR. 35 & SE. COR. 35 AND 1328.0' FROM N 1 FE. IN SEC. 35 AND 1528.0' FROM ON RIGHT LINE (ALSO AT CORRECTION WEST FROM N 1/2 3) BETWEEN SW & SE COR. SEC. 35 DRAWING. SET C.M. 12" DEEP. ALL TIES HAVE BEEN OBLITERATED.

JUNE 1947 — SCHENK ENGINEERING PLAT OF SURVEY IN MISC. BOOK 50, PG. 609 SHOWS SE 🛔 SEC. 35—89—13. SHOWS


S1/4 CORNER OF SEC. 35-89-13 BUT DOES NOT SHOW ANYTHING FOUND.

1956 "BALTIMORE HEIGHTS" - SHOWS S & COR. SEC. 35-89-13 FIFTY (50) FEET SOUTH OF SE. CORNER OF LOT 9 ON SOUTHERLY EXTENSION OF EAST LINE.BUT DOES NOT INDICATE WHAT WAS FOUND.

1956 "LINCOLN HEIGHTS FIRST ADDITION" — SHOWS S \$ COR. SEC. 35—89—13 TWO HUNDRED FORTY—EIGHT (248) FEET SOUTH OF THE SW. CORNER OF LOT 46 ALONG SOUTHERLY EXTENSION OF WEST LINE. BUT DOES NOT INDICATE WHAT WAS

MAY 9, 1963 PLAT OF SURVEY IN MISC. BK. 148-129 SHOWS S \$ CORNER SEC. 35-89-13. BUT DOES NOT INDICATE WHAT WAS FOUND.

SET MAG NAIL & WASHER #16775 ON A LINE TWO HUNDRED FORTY-EIGHT (248) FEET SOUTH OF THE SW. CORNER OF LOT 46 ALONG SOUTHERLY EXTENSION OF WEST LINE. THIS FITS WELL WITH UNPLATTED PARCELS ALONG E. RIDGEWAY AVE. IN THE SE & OF SECTION 35. THIS CERTIFICATE WAS FILED BECAUSE THERE IS NO CERTIFICATE ON FILE.

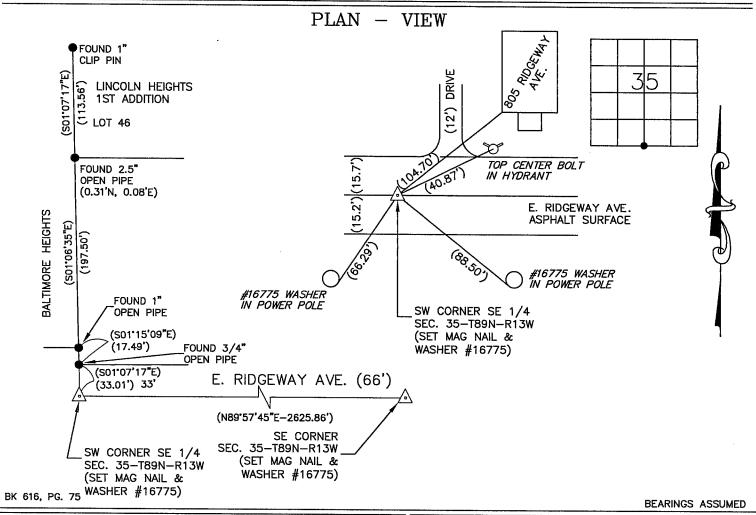

I hereby certify that this land surveying document was prepared and the related survey work was performed by me or under my direct personal supervision and that I am a duly Licensed Land Surveyor under the laws of the State of lowa. Sianature: David L. Scheil, 2008 _ Lic. No. <u>1677</u>5 Pages or Sheets Covered by this Seal: THIS SHEET ONLY. My license renewal date is December 31, 2008

SEAL

List Corners to be Indexed Corners Section Twp Ranae S 1/4 CORNER, 35 89 N 13 W ammanananana OAVID L. SCHOOL LICENSED 16775 IOWA NO SURVEYO

