

SC
MISC
INDEX 11
MARGIN
PROOF
COMPARE

BLACK HAWK COUNTY IOWA:SS
FILED FOR RECORD JULY 6, 1999 AT
4:00 P. M. AND RECORDED IN BOOK 334
OF MISC PAGE 999.

477

Christine J. Less RECORDER
FEE 1-5.00/

CITY OF CEDAR FALLS

R. Allen Dietz, L.S. for the City of Cedar Falls
217 Washington Street Cedar Falls, Iowa 50613 Ph. (319) 273-8606

UNITED STATES PUBLIC LAND SURVEY CORNER CERTIFICATE OF


Land Survey Monuments situated in Section No. 2, Township No. 89 North, Range
No. 14 West, of the Fifth Principal Meridian, Black Hawk County, Iowa.
Previously recorded in Book N/A on Page N/A in the office of the County Recorder.
(book, page, document number, etc.)

(Show reason for preparing this certificate, the evidence and detailed procedures used in establishing the corner positions and monumentation found or placed.)

Monument Description and Remarks: Found nail in asphalt pavement before
construction. Referenced to P-K nails in sidewalk joints as shown.
Set P-K nail in new asphalt after street overlay using ties to P-K nails set before
construction.

PLAN - VIEW

(Show a minimum of three reference ties to durable physical objects, relevant monuments and physical conditions that will enable recovery of the corner.)

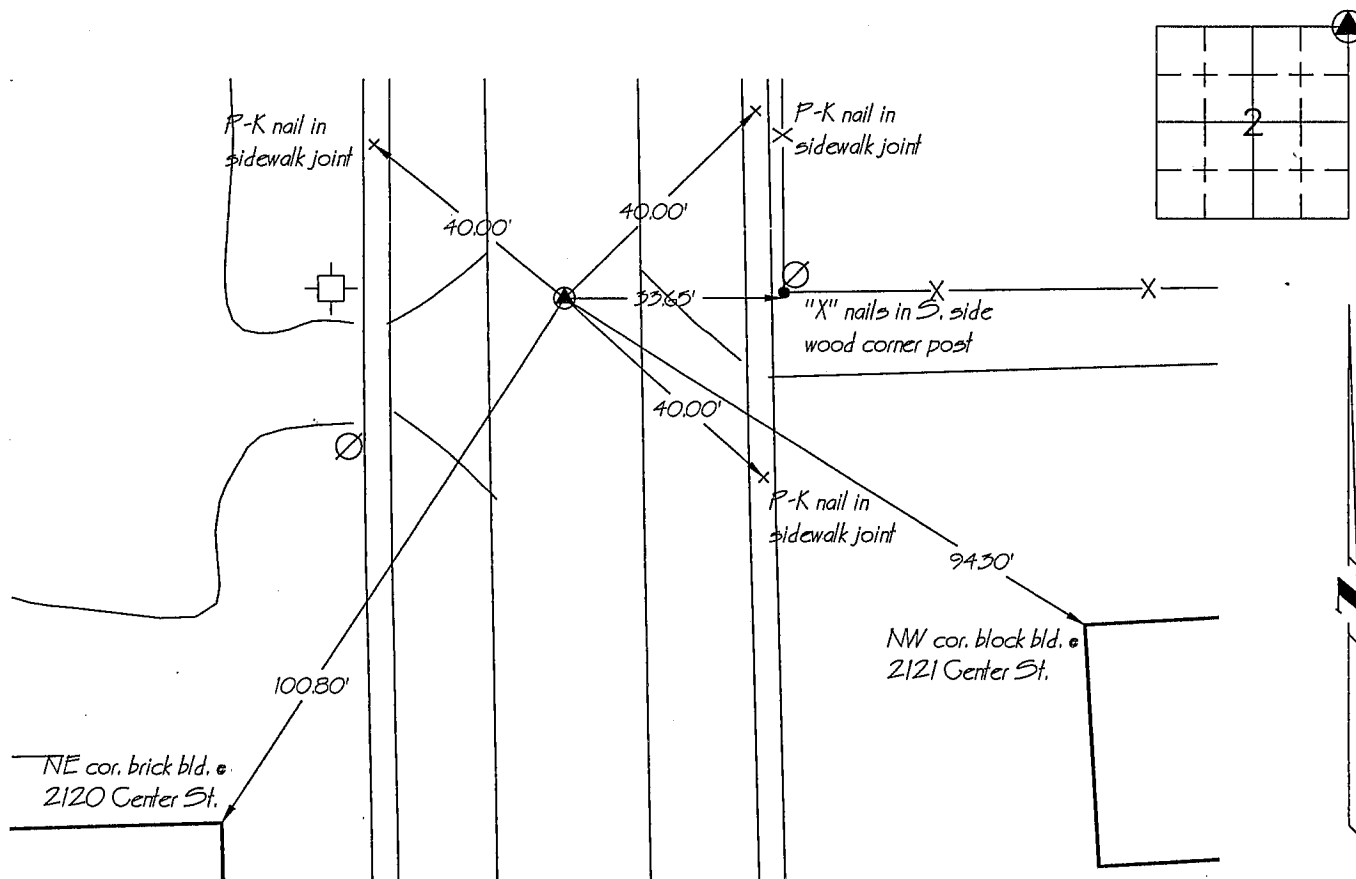


I hereby certify that this land surveying document was prepared by me or under my direct personal supervision and that I am a duly licensed Professional Land Surveyor under the laws of the State of Iowa.

Signed: *R. Allen Dietz*
R. Allen Dietz Iowa License No. 12086

Date: *1 July* 1999

SEAL

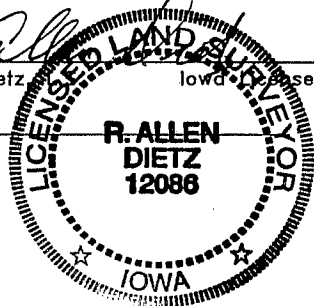

My License renewal date is December 31, 2000.
Pages or sheets covered by this seal : this page only

Corners	List Corners to be Indexed Section	Twp	Range
NE cor.	2	89	14

334 PAGE 999

Drawn by : RR

Checked by : RAD